


T. 2S. R. 2W W.M.

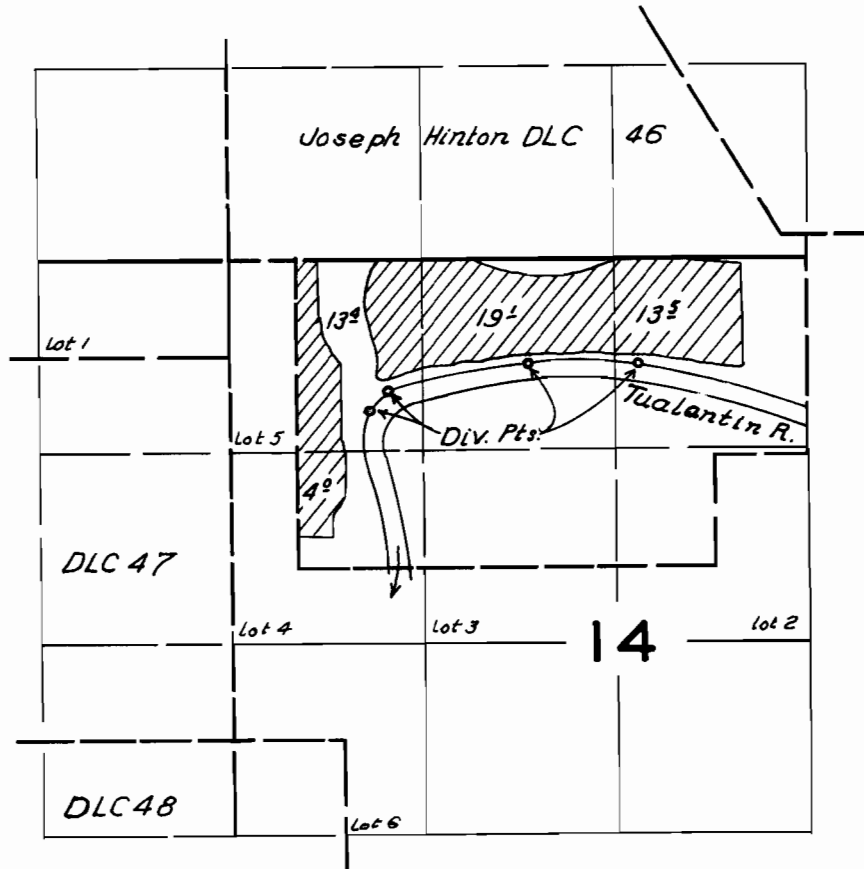

FINAL PROOF SURVEY
UNDER

Application No. 30587 Permit No. 24089
IN NAME OF

G. W. Munger

Surveyed Sept. 16 1959, by C.O. Bartels