


T.36S.R.5W.W.M.

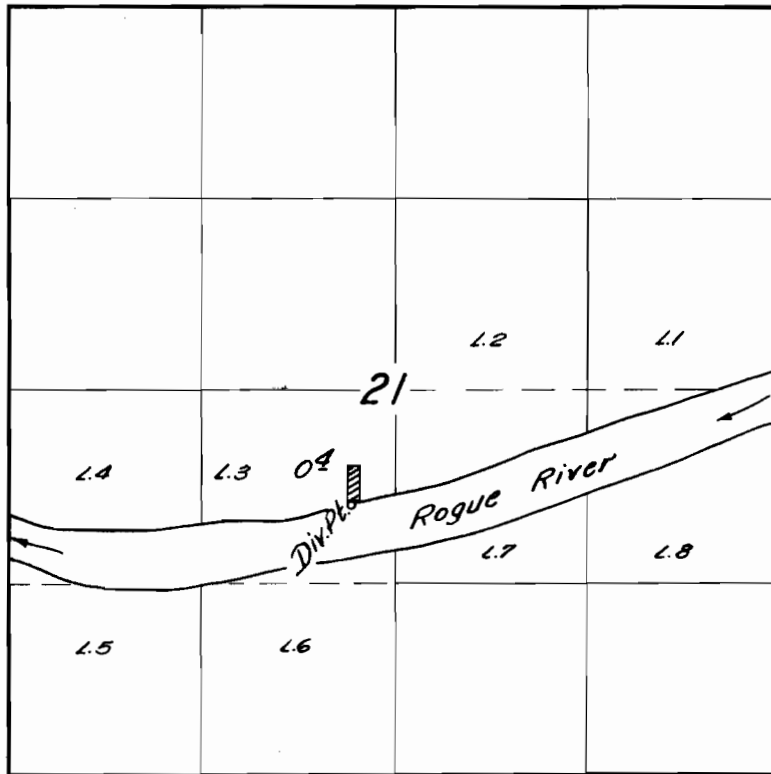

FINAL PROOF SURVEY

UNDER

Application No. 30606 Permit No. 24116

IN NAME OF

Mrs. Truman F. Donaldson

Surveyed July 14, 1959, by C. D. Britts