


24127

27284

T. 36S. R. 10E. WM.

Sprague River

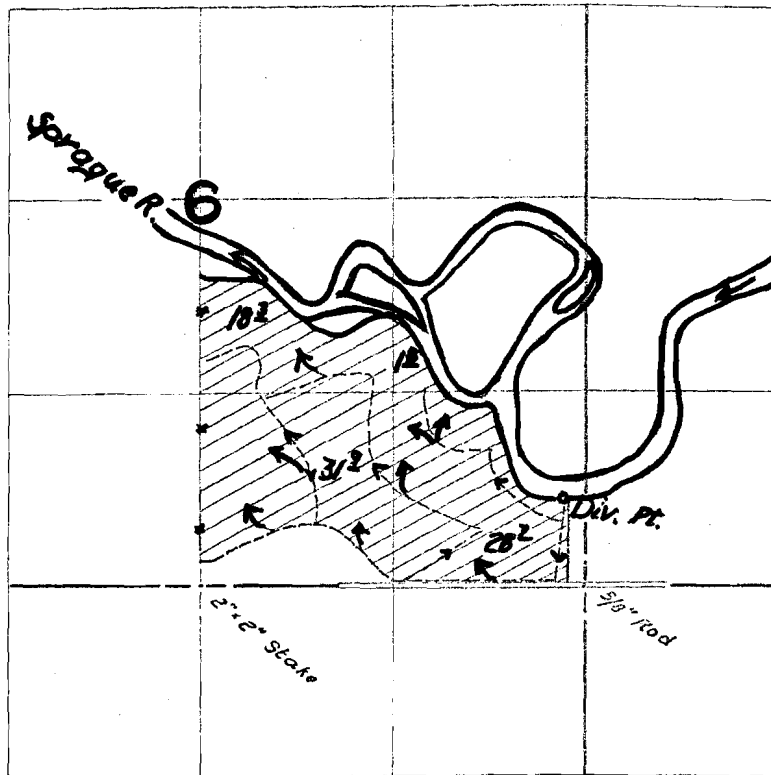

FINAL PROOF SURVEY

UNDER

Application No. 30623 Serial No. 24127

IN FAVOR OF

Emmet J. & Mildred Lakoda

Surveyed Oct. 24 1959 by R. H. Jackson