


T. 15 S. R. 6 W. W. M.

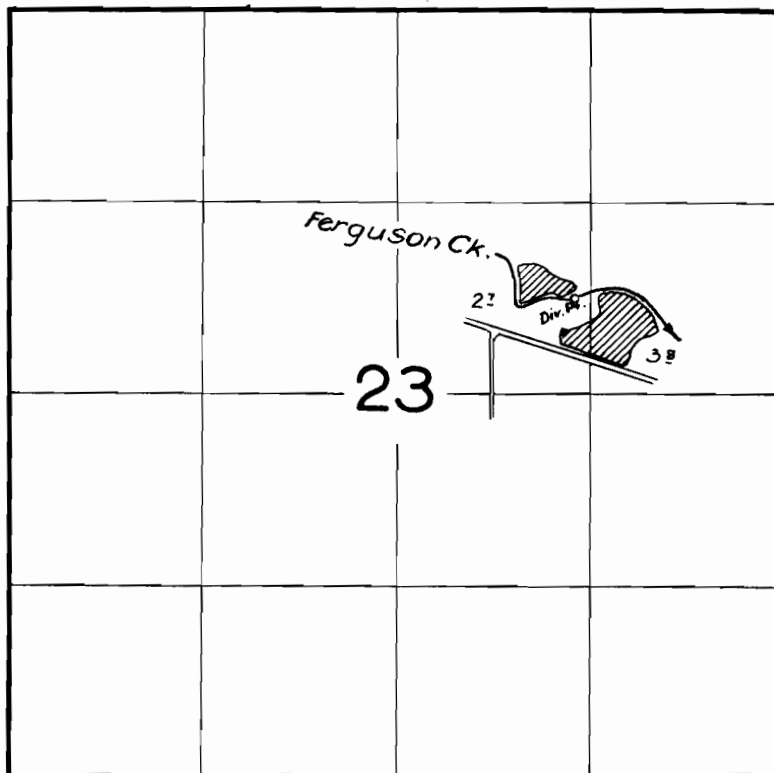

FINAL PROOF SURVEY
UNDER

Application No. 30903 Permit No. 24411...
IN NAME OF

EFFIE GERTRUDE BLAIR

Surveyed Mar. 30 1959, by *R. Jackson*