


T.13 S.R.6 W.W.M.

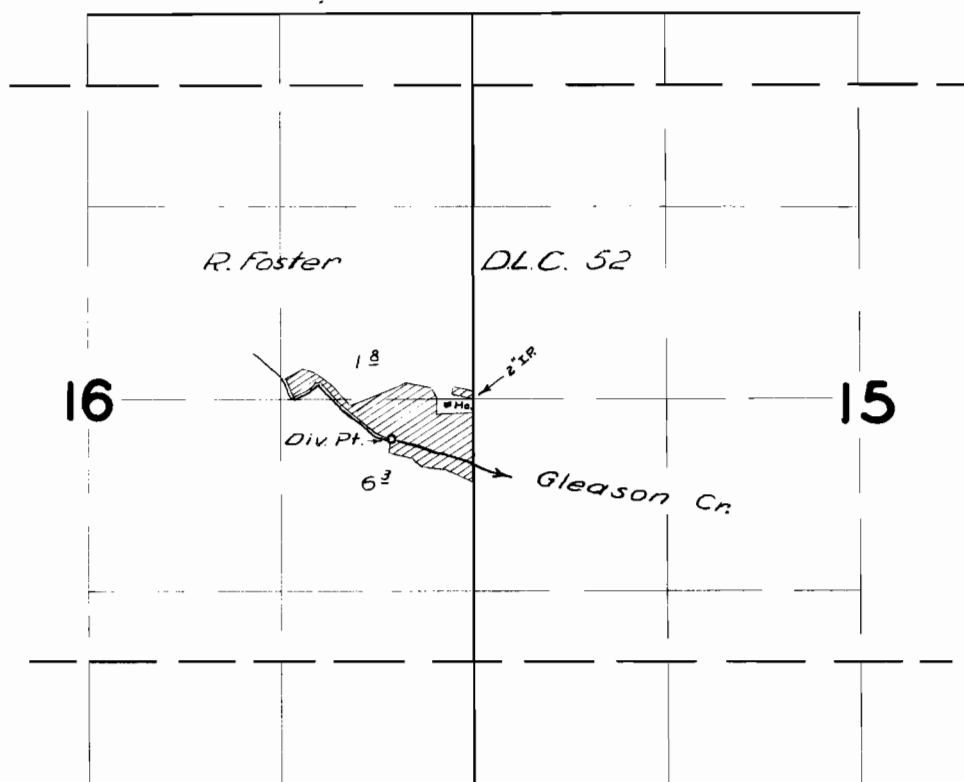

FINAL PROOF SURVEY
UNDER

Application No. 30992 Permit No. 24448
IN NAME OF

ARNOLD G. & RUBY QUIGLEY

Surveyed *MAR 10 1959*, by *M. Bish*