


T. 37 S. R. 5 W. W.M.

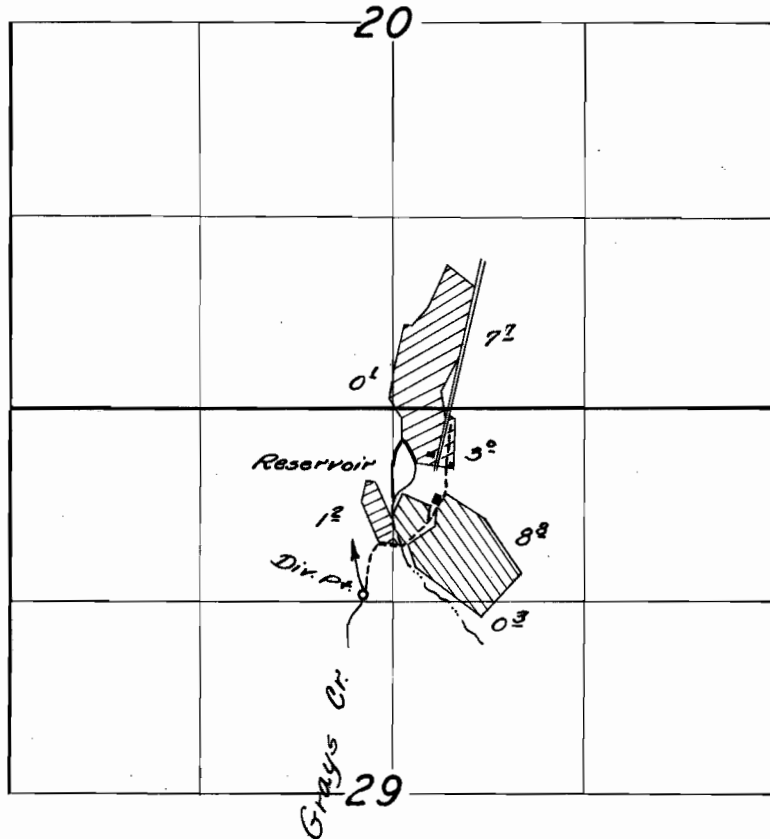

FINAL PROOF SURVEY

UNDER

Application No. R-31038 ~~31039~~ Permit No. R-1923 ~~24856~~

IN NAME OF

Harold D. Eifer

Surveyed July 18, 1959, by CO Bartels