
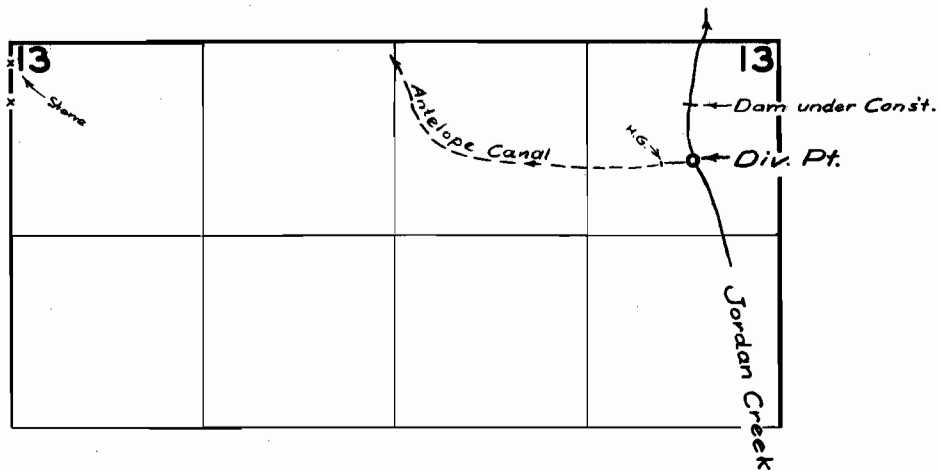


T.30 S.R.46 E.W.M.

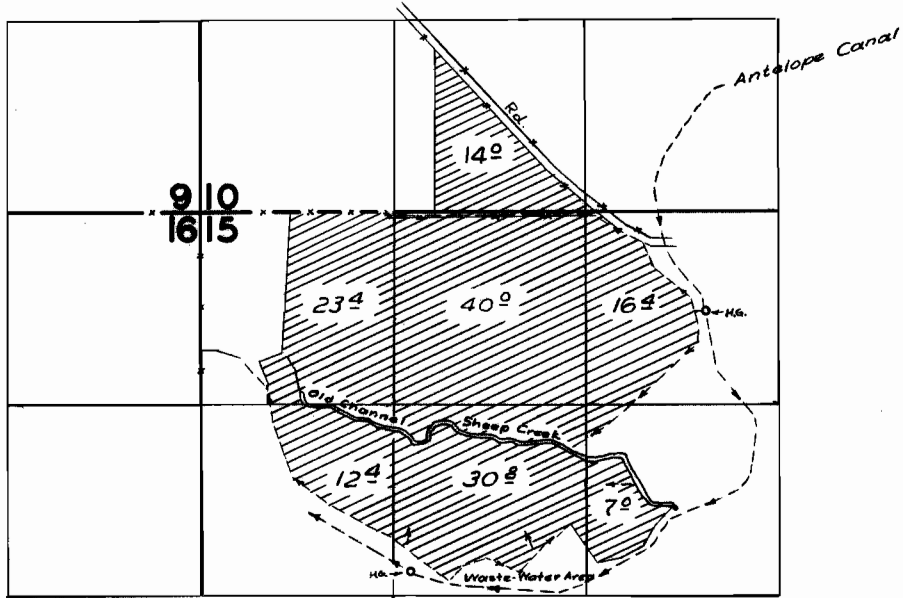

FINAL PROOF SURVEY

UNDER

Application No. 30891 Permit No. 24535

IN NAME OF

Joaquin & Felix Jaca

Surveyed 25 Sept 1959, by M. A. Bick