


T. 3 N. R. 10 W. W.M.

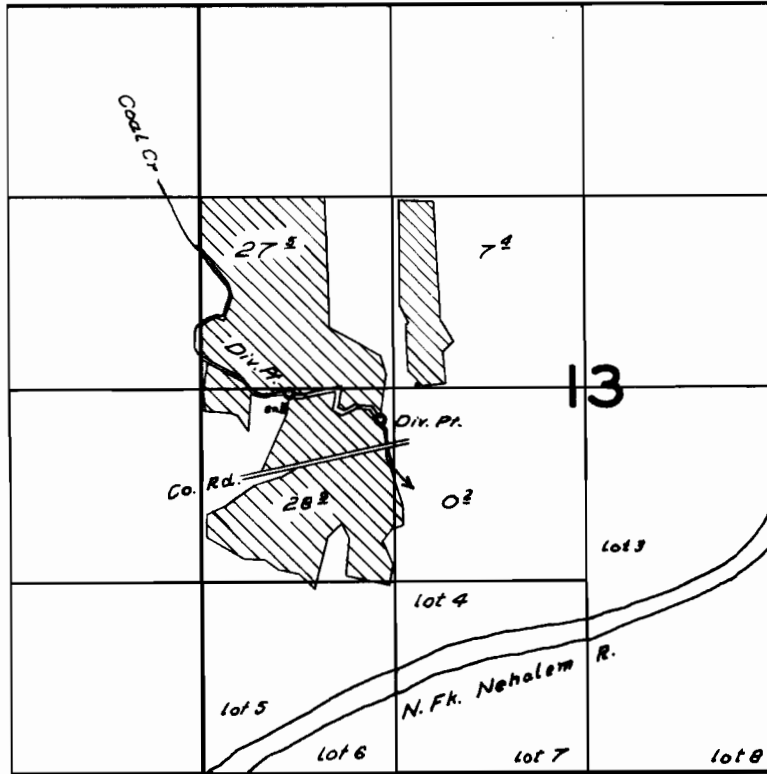

FINAL PROOF SURVEY
UNDER

Application No. 31252 Permit No. 24623
IN NAME OF

M. O. Woodward

Surveyed April 14 1959, by R. H. Jackson