


T.39 S.R.41 E.W.M.

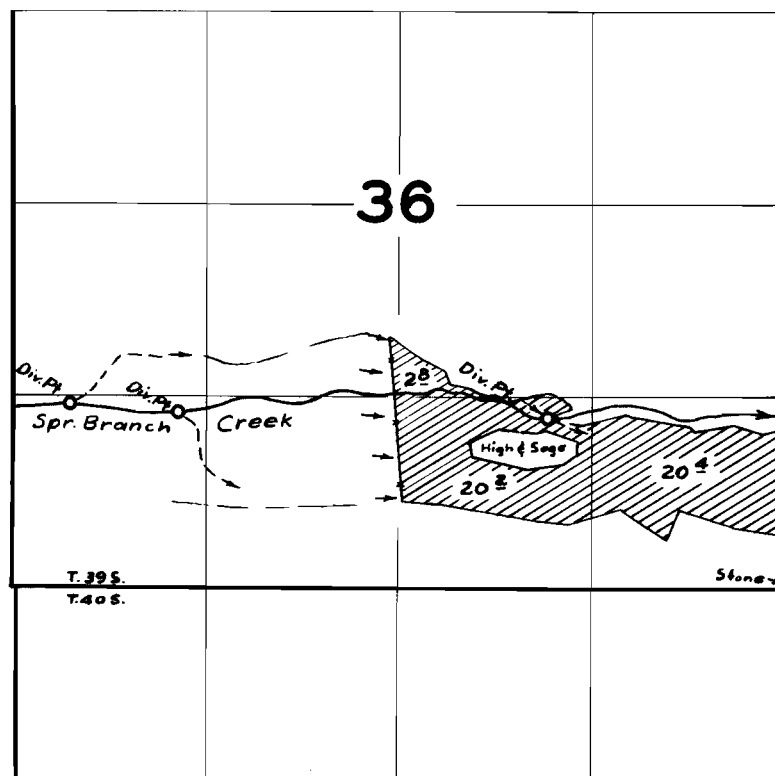

FINAL PROOF SURVEY
UNDER

Application No. 30612 Permit No. 24715
IN NAME OF

STATE OF OREGON - STATE LAND BOARD

Surveyed 19 Sept. 1959, by *Tr. Bick*