


T.36S. R.5W.W.M.

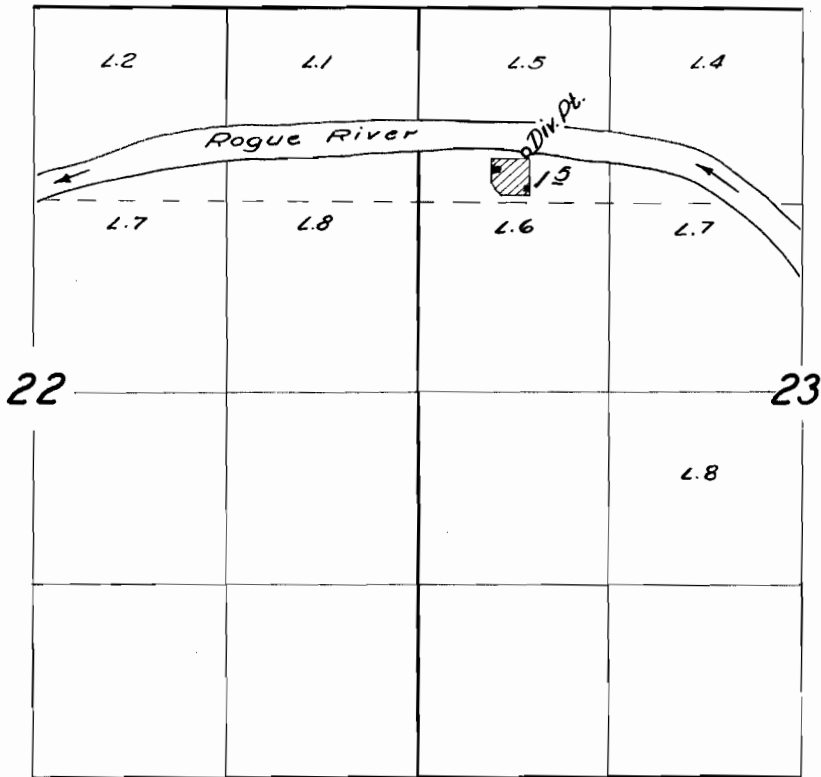

FINAL PROOF SURVEY

UNDER

Application No. 31378 Permit No. 24740

IN NAME OF

Dietz Newland

Surveyed July 14 1959, by C. O. Bartels