


T. 5S. R. 1W.W.M.

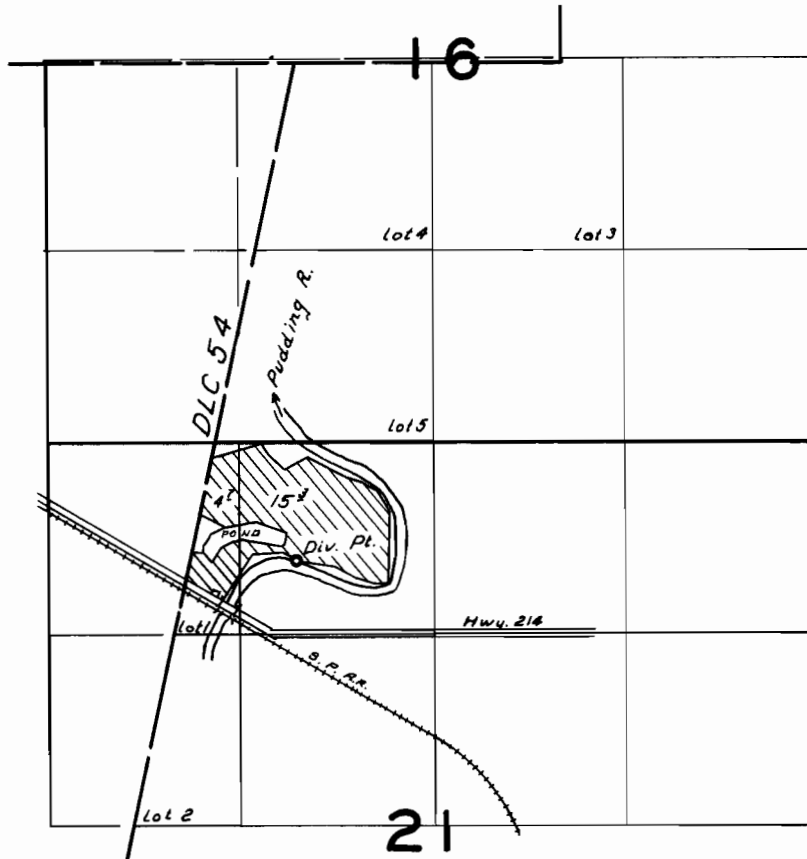

**FINAL PROOF SURVEY**  
UNDER

Application No. 31382..... Permit No. 24743 ..  
IN NAME OF

Allen L. Larson .....

Surveyed May 21, 1959, by R. H. Jackson. ....