


T.17S. R.8W. W.M.

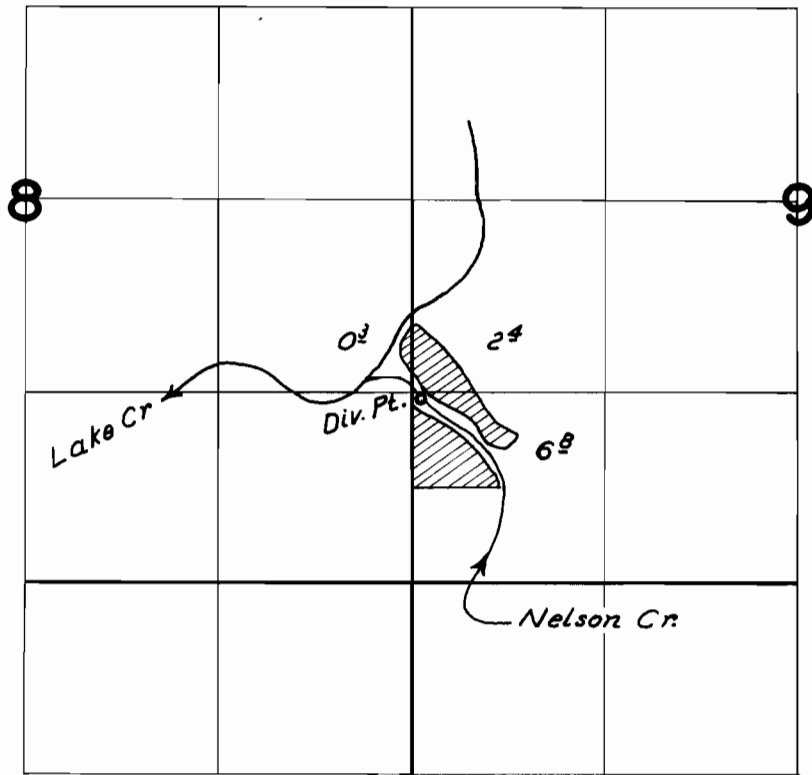

FINAL PROOF SURVEY

UNDER

Application No. 31527 Permit No. 24865

IN NAME OF

Oliver Wilcut

Witness March 24 1959, by C.O. Bartels