


T.20 S.R.47 E.W.M.

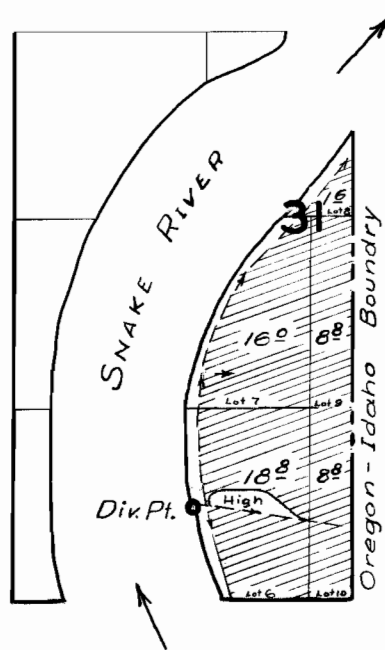

FINAL PROOF SURVEY UNDER

Application No. 31572 Permit No. 24911
IN NAME OF

THE STATE OF OREGON, STATE LAND BOARD

Surveyed 16 Sept. 1959, by M. Bech