


T. 6S. R. 1E.W.M.

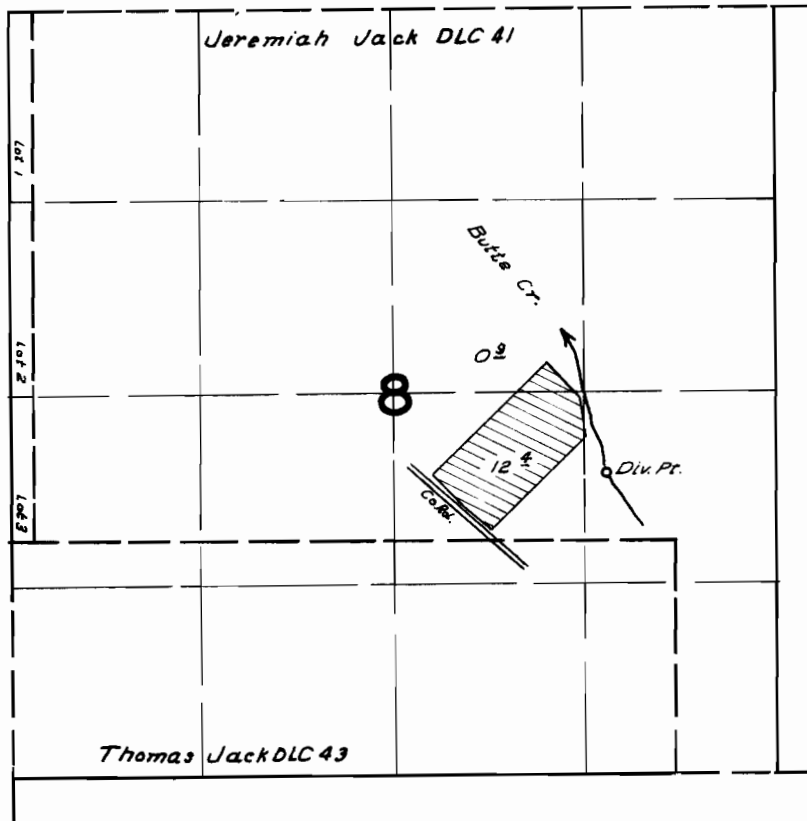

FINAL PROOF SURVEY
UNDER

Application No. 32276 Permit No. 25457
IN NAME OF

Mrs. Cora Long

Surveyed March 16 1959, by R. H. Jackson.