


T.17S. R.1W.W.M.

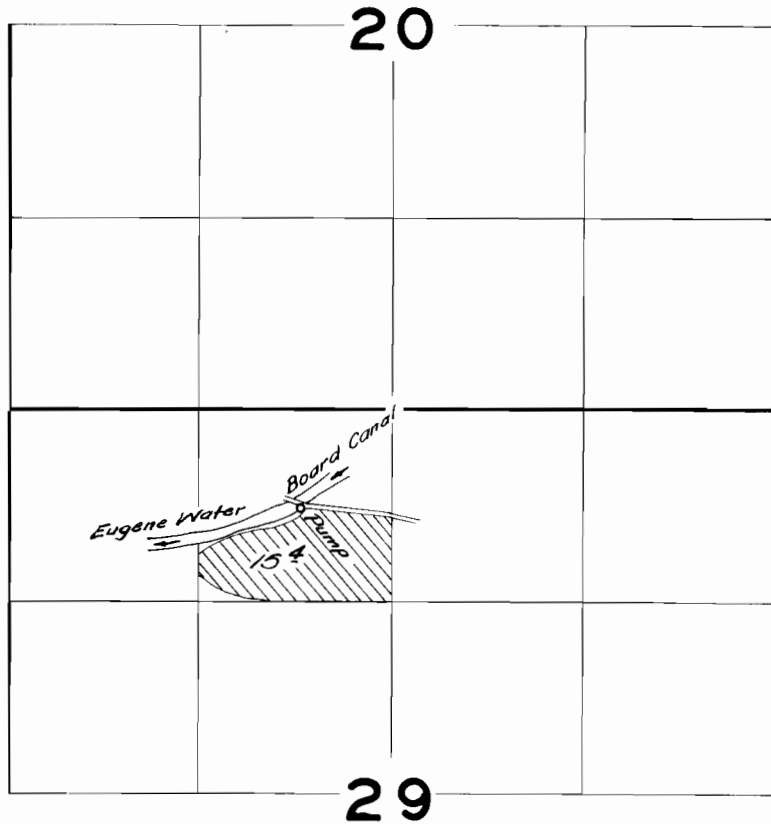

FINAL PROOF SURVEY
UNDER

Application No. 32294 Permit No. 25489
IN NAME OF

Wayne Endicott

Surveyed April 7 1959, by C.O. Bault