


T. 11 S. R. 4 W. W. M.

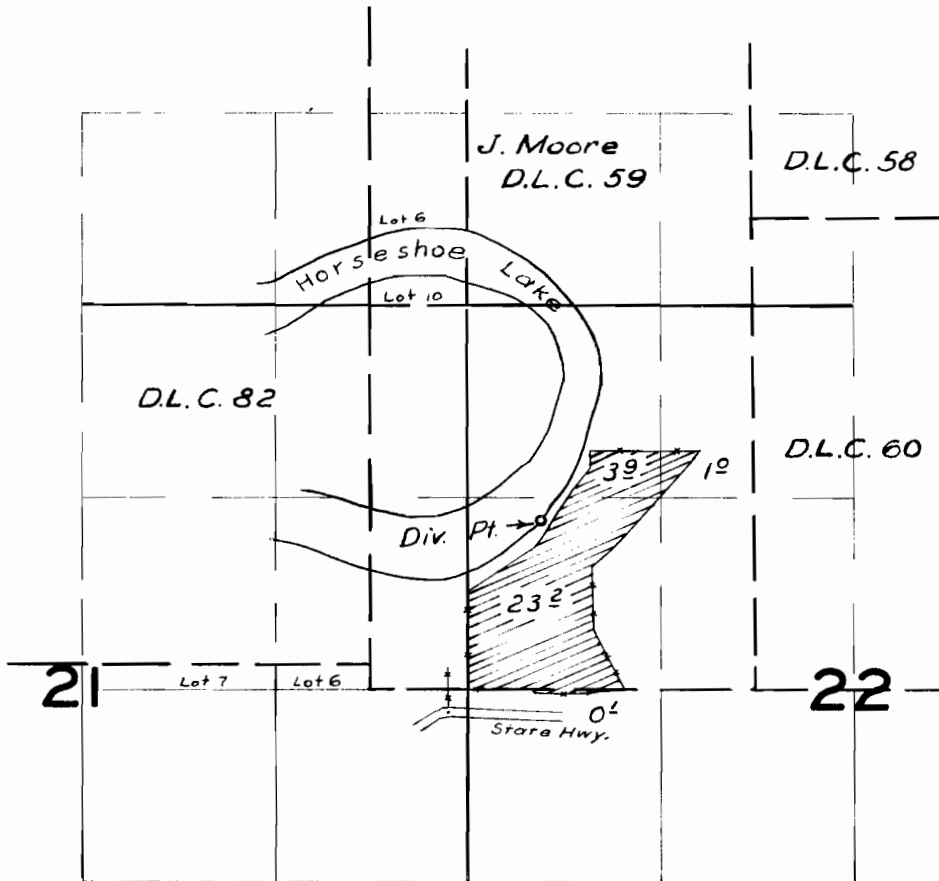

FINAL PROOF SURVEY
UNDER

Application No. 32336 Permit No. 25529
IN NAME OF

OREN & HELEN GILBERT

Surveyed 28 July 1959, by *M. B. Rich*