


# T.27 S.R.15 E.W.M.

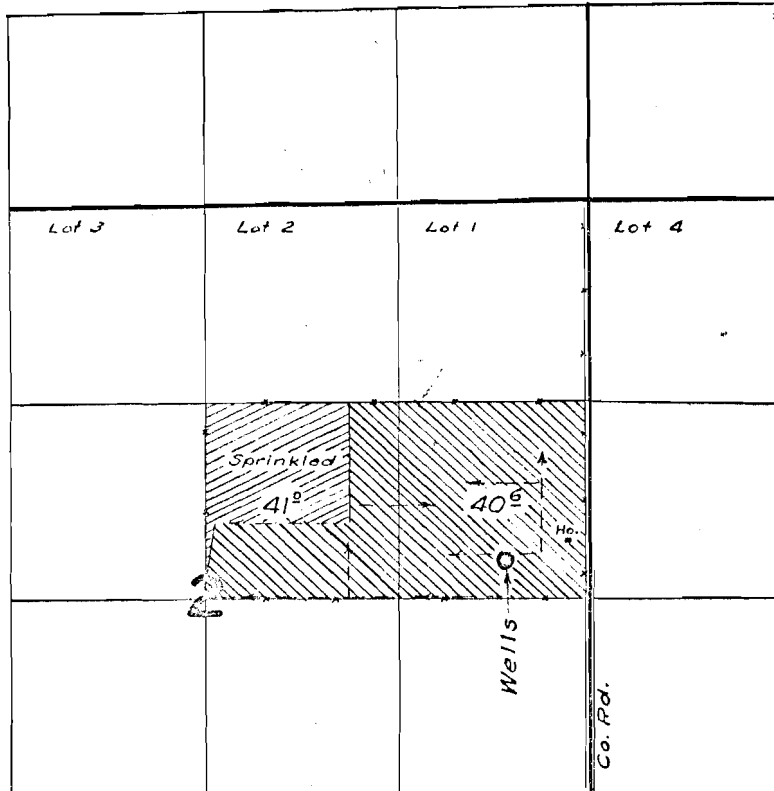

## FINAL PROOF SURVEY UNDER

Application No. U-426 Permit No. U-394  
IN NAME OF

OWEN PITCHER

Surveyed 8 May 1959, by M. B. Sch

✓