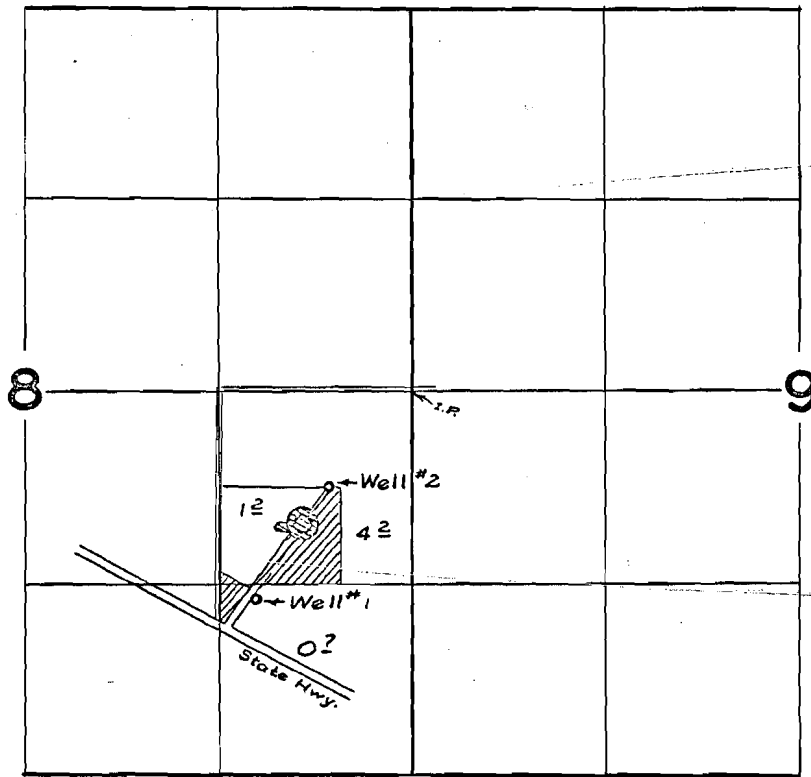

 


U-469
27309

T.39 S.R.10 E.W.M.



Well #1 
 Well #2 

FINAL PROOF SURVEY

UNDER

Application No. U-487 Permit No. U-469

IN NAME OF

MT. CALVARY CEMETERY ASSOC. INC.

Surveyed 17 Oct. 1959, by M. Bish

Just for wells