


copy

U-632

# T.6N. R.35E.W.M.

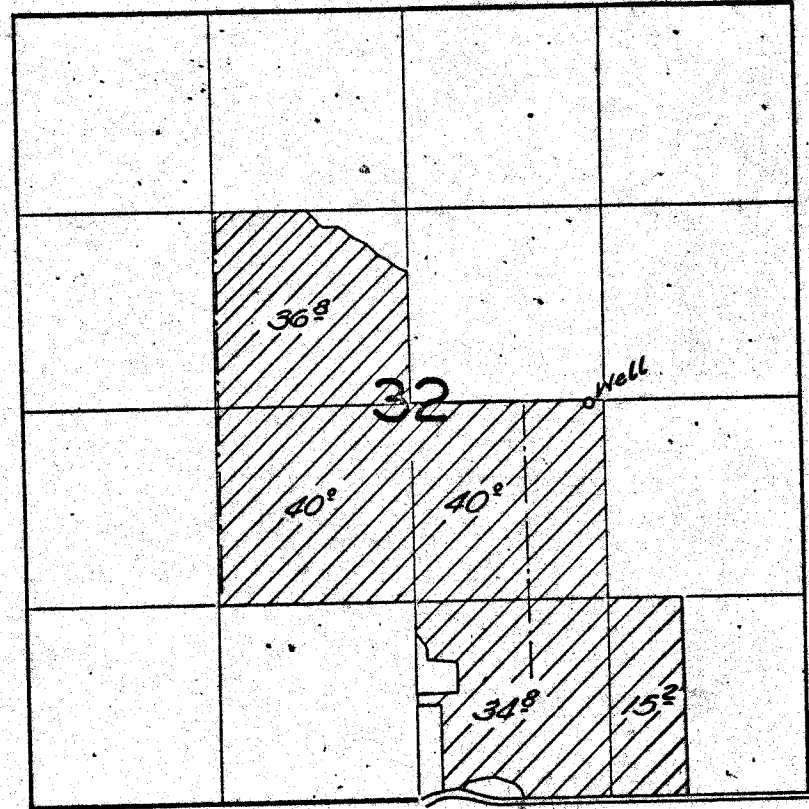

## FINAL PROOF SURVEY

UNDER

Application No. U-700 Permit No. U-632

IN NAME OF

James Taylor

Surveyed Oct. 27, 1959, by C.O. Bault