


T. 11 S. R. 4 W. W. M.

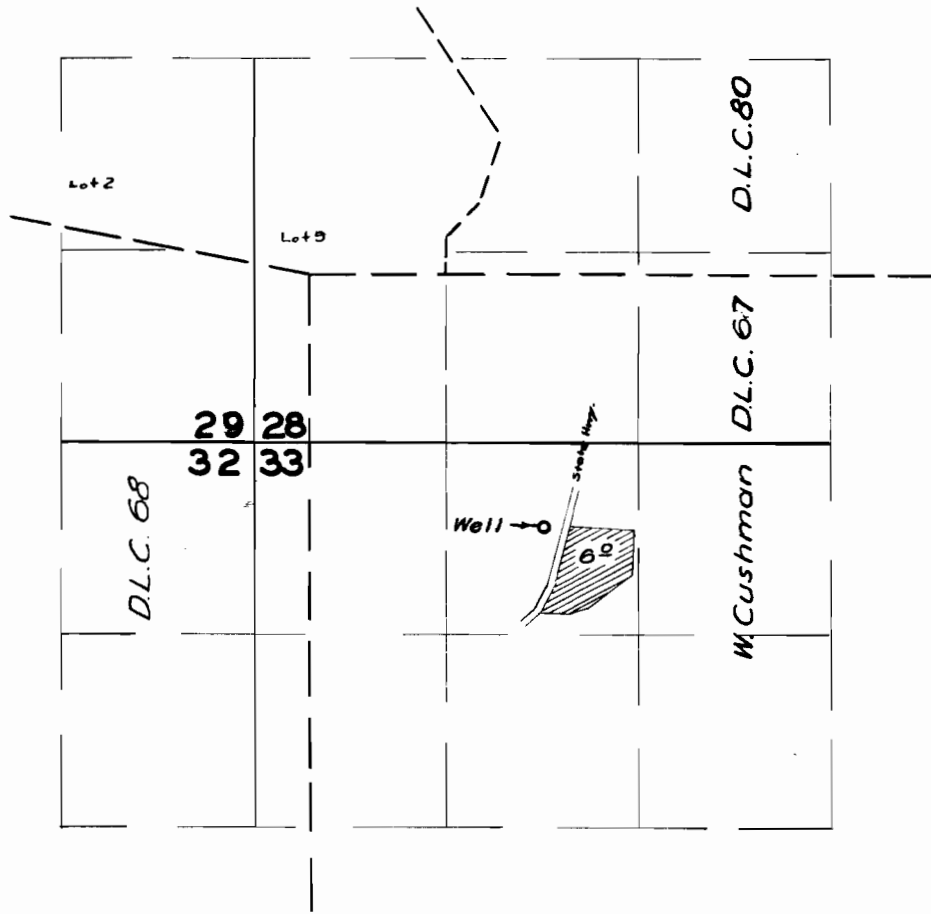

FINAL PROOF SURVEY UNDER

Application No. G-223 Permit No. G-140
IN NAME OF

TWIN OAKS MEMORIAL GARDENS INC.

Surveyed 29 July 1959, by M. Bieh