


T. 5S. R. 1W. W.M.

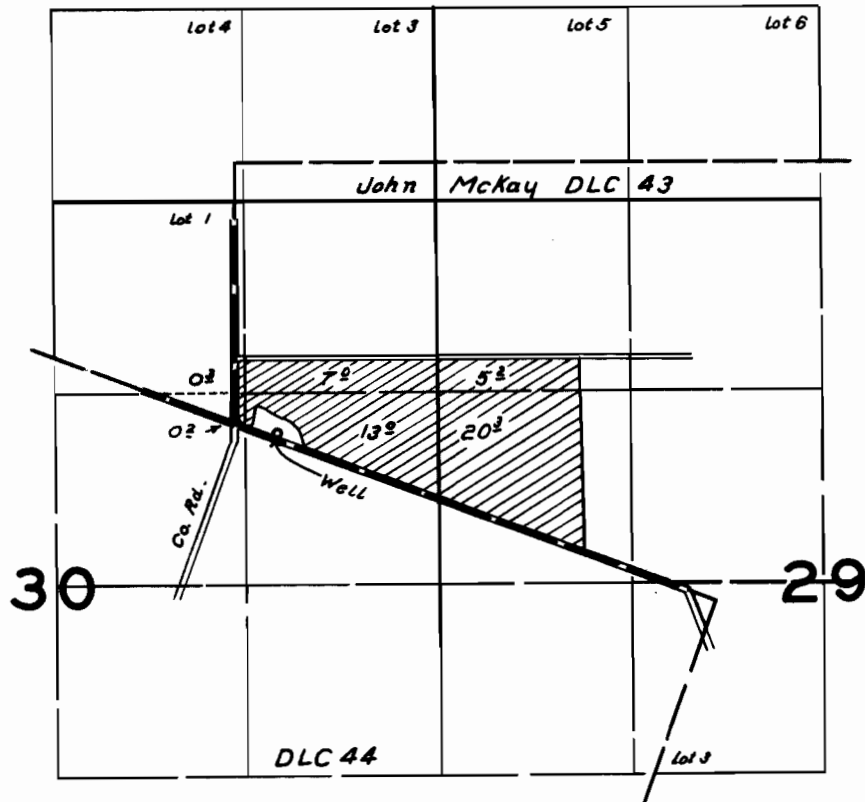

FINAL PROOF SURVEY UNDER

Application No. *G240* Permit No. *G147*
IN NAME OF

Joseph Serres

Surveyed *April 23 1959*, by *R.H. Jackson*