


27315
T8020

T.26 S.R.18 E.W.M.

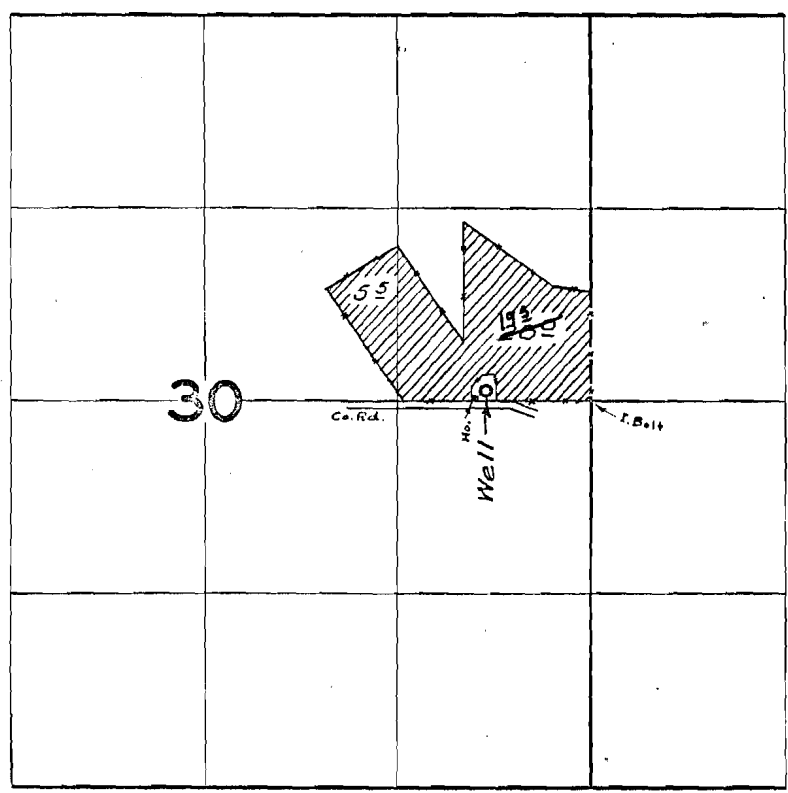

FINAL PROOF SURVEY UNDER

Application No. G-61 Permit No. G-155
IN NAME OF

Sam K. Morehouse

Surveyed 13 May 1959, by M. Bush

