


T. 17S. R. 5W. WM.

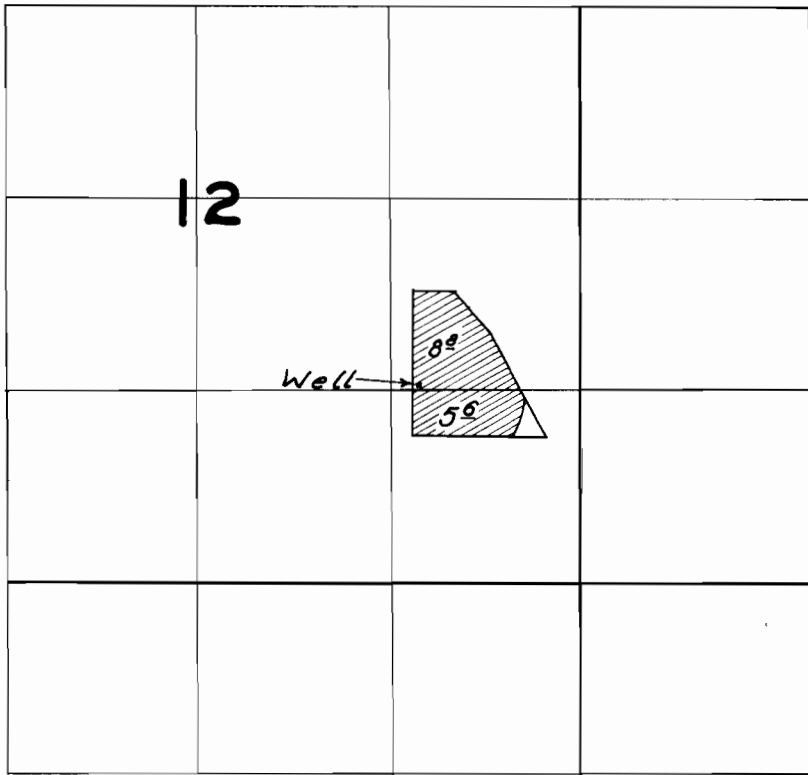

FINAL SURVEY

6394 6274

A. W. Schneider

April 2 59 C. O. Bartels

*AB*  
1959X