


# T.40 S.R.12 E.W.M.

Just River well

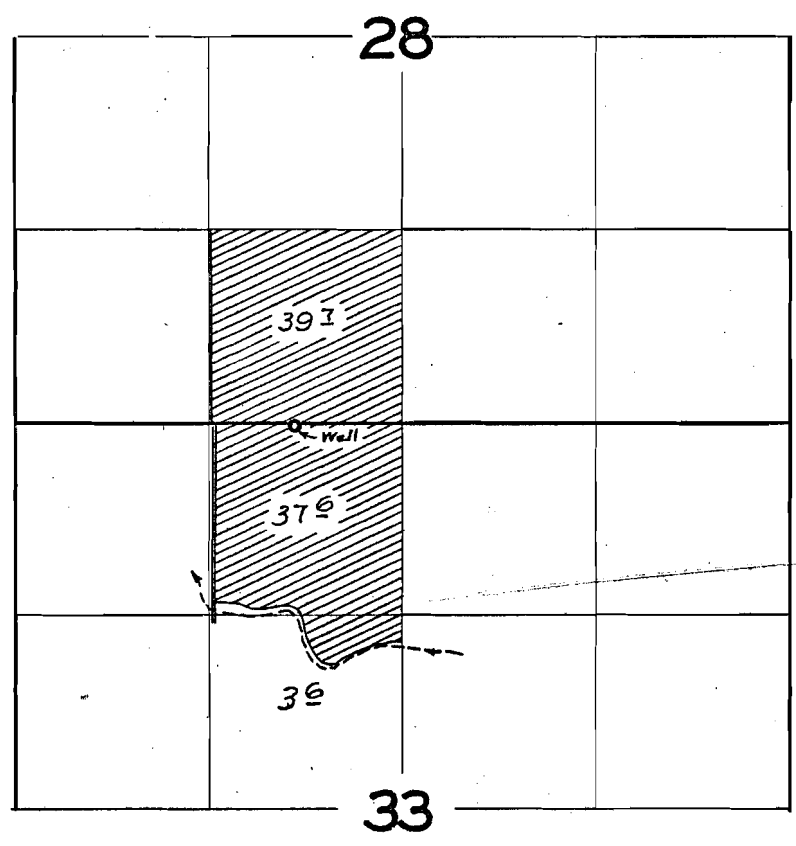

## FINAL PROOF SURVEY

UNDER

Application No. G-387 Permit No. G-365

IN NAME OF

JOHN MADDEN

Surveyed 10 Oct. 1959, by m. Rich