


T.17S. R. 4W.W.M.

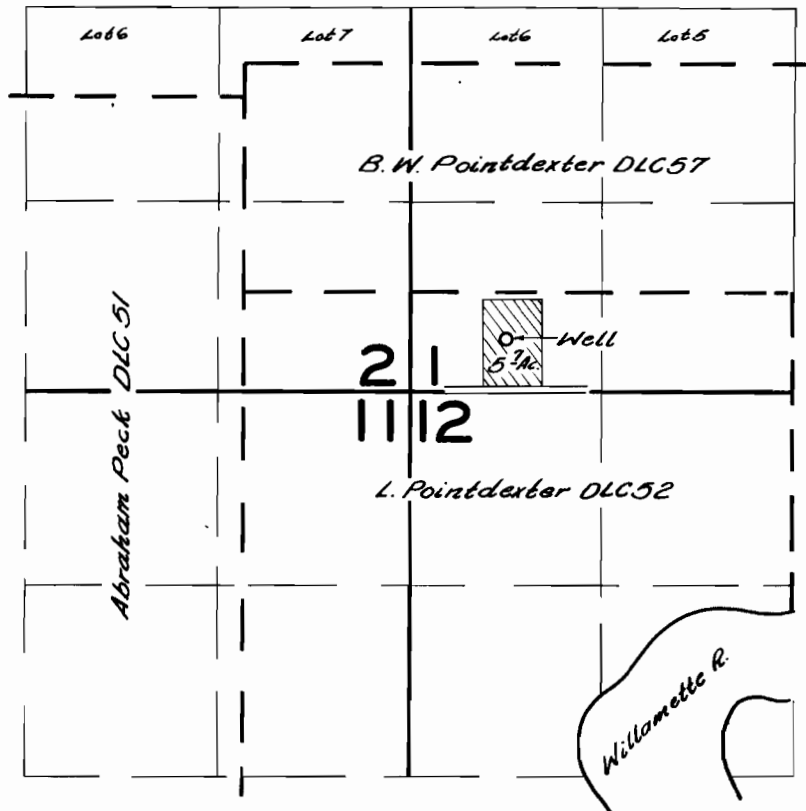

FINAL PROOF SURVEY
UNDER

Application No. G-606 Permit No. G-507
IN NAME OF

Gilbert C. Smith

Surveyed March 23 1959, by C. W. Baugh