


T.17 S. R.1 W.W.M.

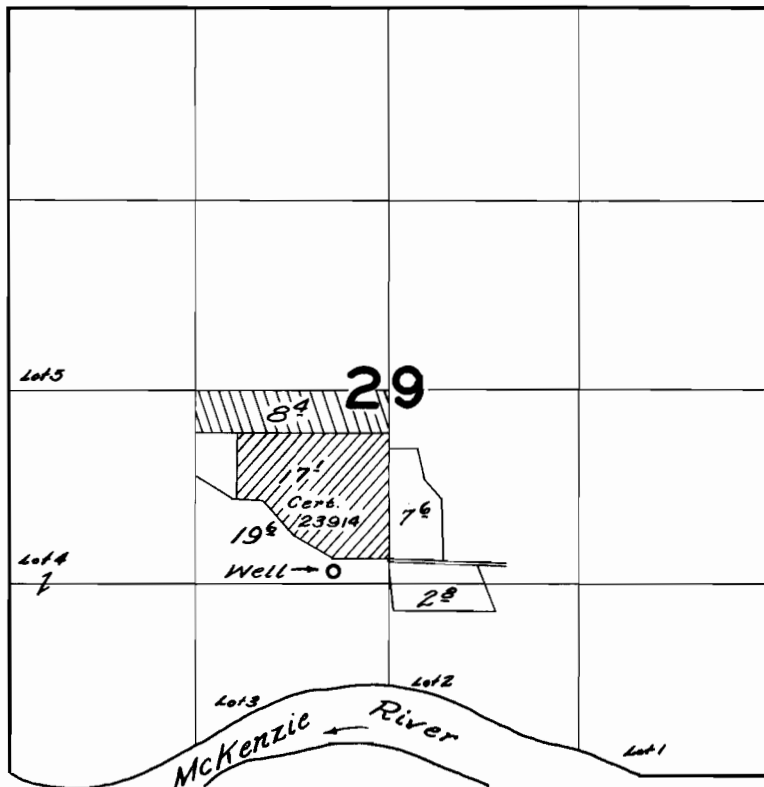

FINAL PROOF SURVEY
UNDER

Application No. *G-559* Permit No. *G-607*
IN NAME OF

Wayne Endicott

Surveyed *April 7* 1959, by *C.D. Baith*