


T.17S. R.4W.W.M.

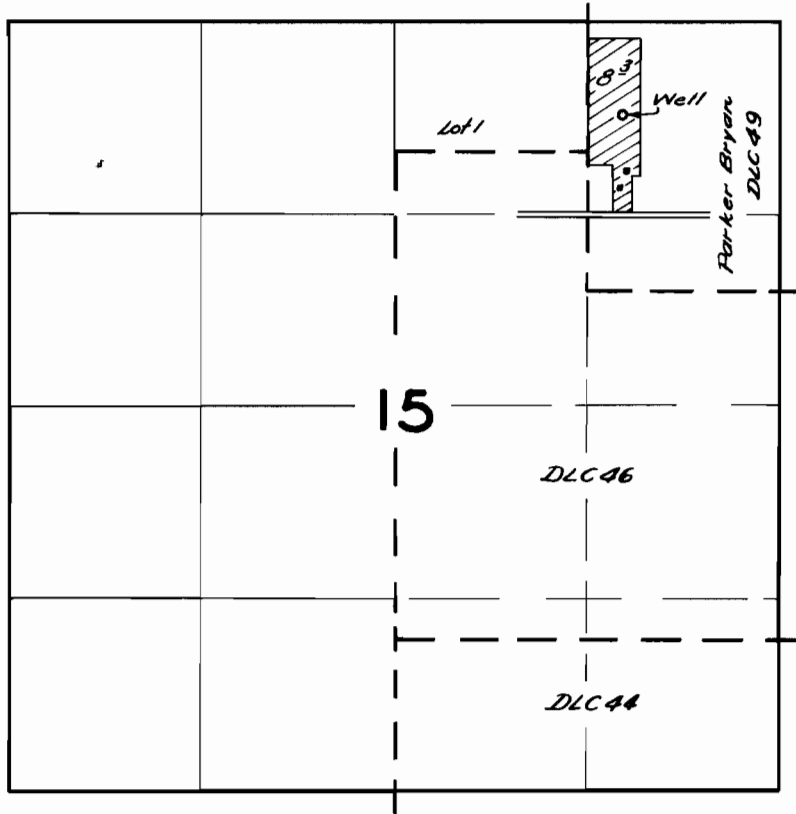

FINAL PROOF SURVEY
UNDER

Application No. *G-720* Permit No. *G-694*
IN NAME OF

GLEN GOTCHER

Surveyed *APRIL 10* 1959, by *C.O. Bartsch*