


G-864
74533
27326

T.6N. R.35E.W.M.

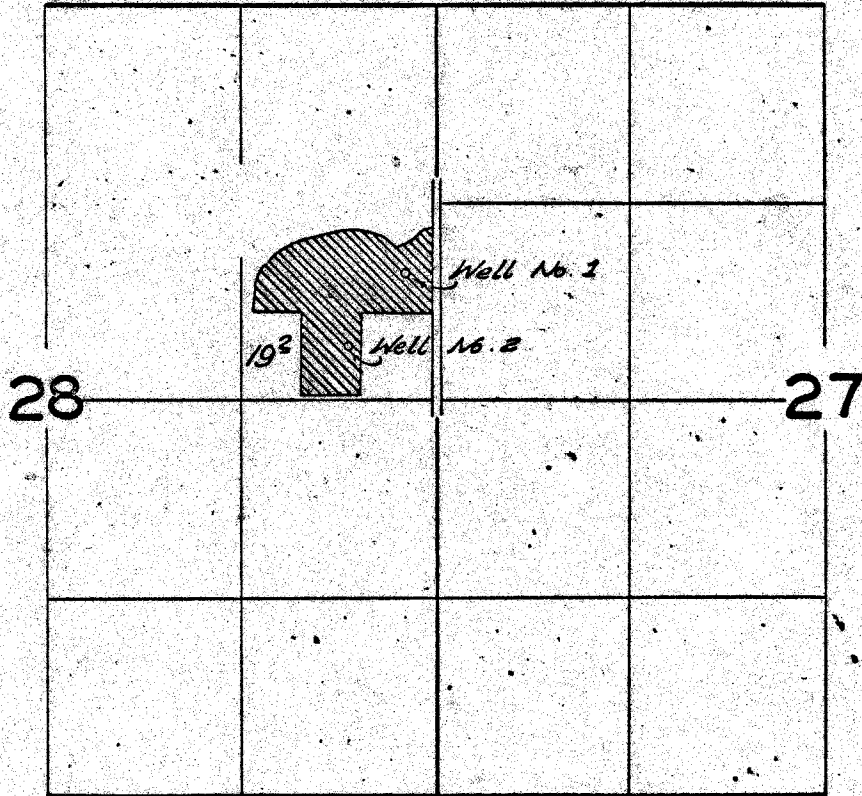

FINAL PROOF SURVEY

UNDER

Application No. G-972 Permit No. G-864

IN NAME OF

Walter J. Rand

Surveyed Oct. 28, 1959, by C.O. Bartels