


T.9S.R.1W.W.M.

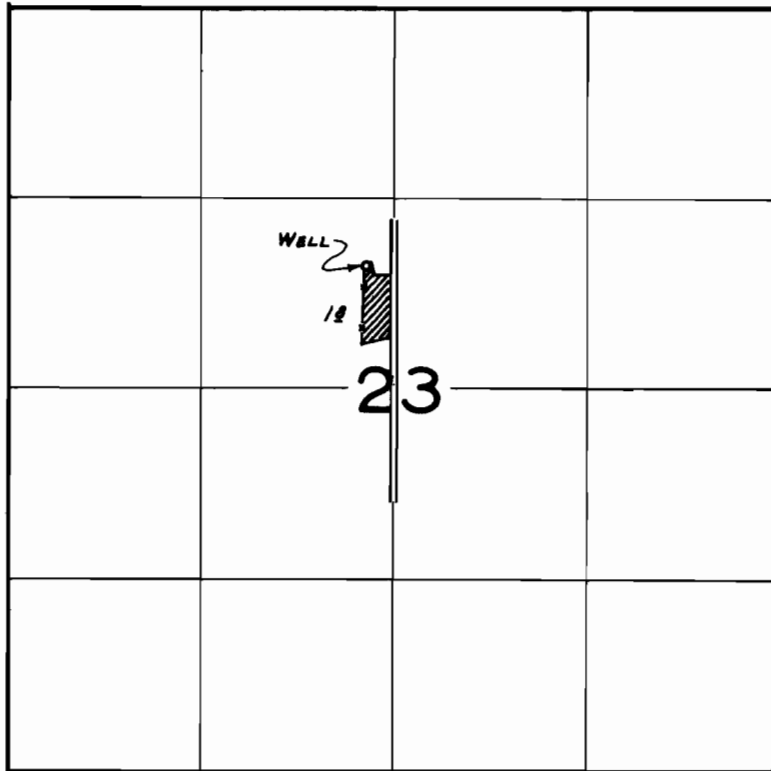

FINAL PROOF SURVEY
UNDER

Application No. *G:1154*..... Permit No. *G:989*.....
IN NAME OF

ARTHUR & ANGELINE SANDNER

Surveyed *Nov. 2* 19*59*, by *M. Bish*.....