


6-1136
27329

T.26 S.R.15 E.W.M.

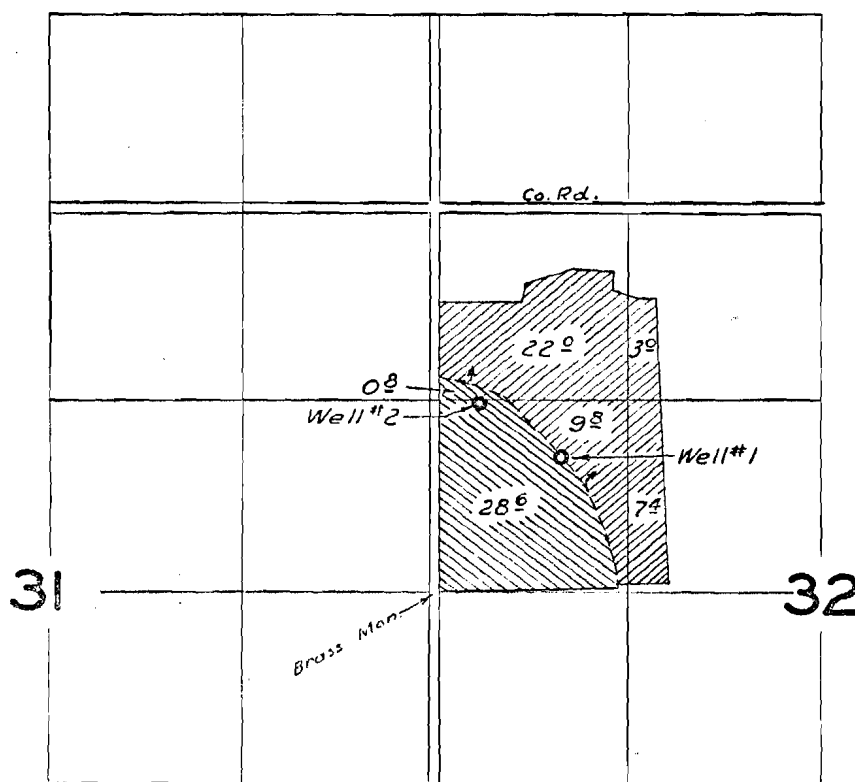

FINAL PROOF SURVEY
UNDER

Application No. G-1292 U-508 Permit No. G-1136 U-512
IN NAME OF

RICHARD SCHAUB

Surveyed 9 May 1959 by W. Rich