


T.40 S.R.11 E.W.M.

East River wells

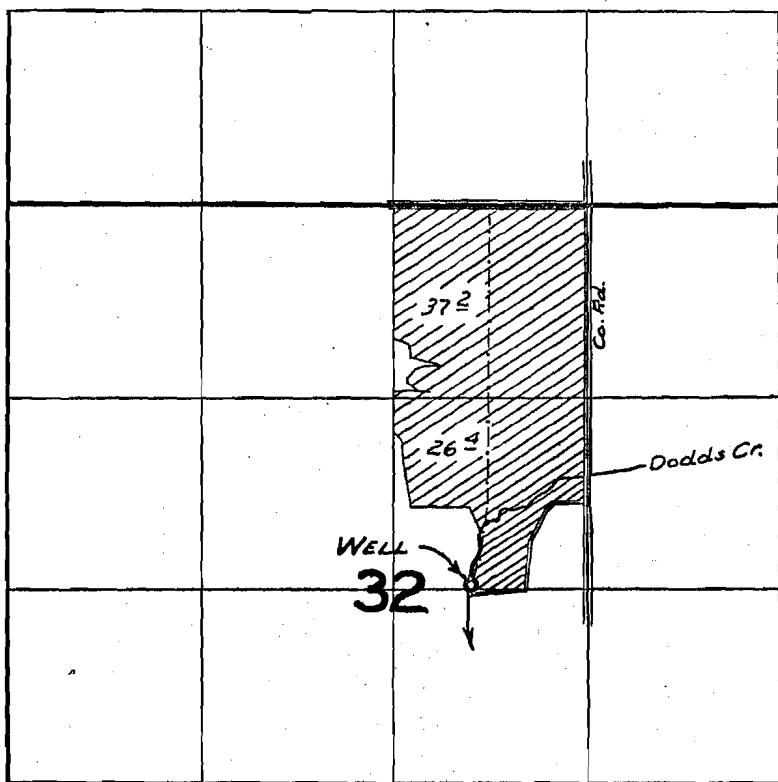

FINAL PROOF SURVEY

UNDER

Application No. G-1257 Permit No. G-1157

IN NAME OF

CHARLES V. SHUCK

Surveyed 24 Oct. 1959, by Tom R. Rich