


T. 12S. R. 36&37E. W.M.

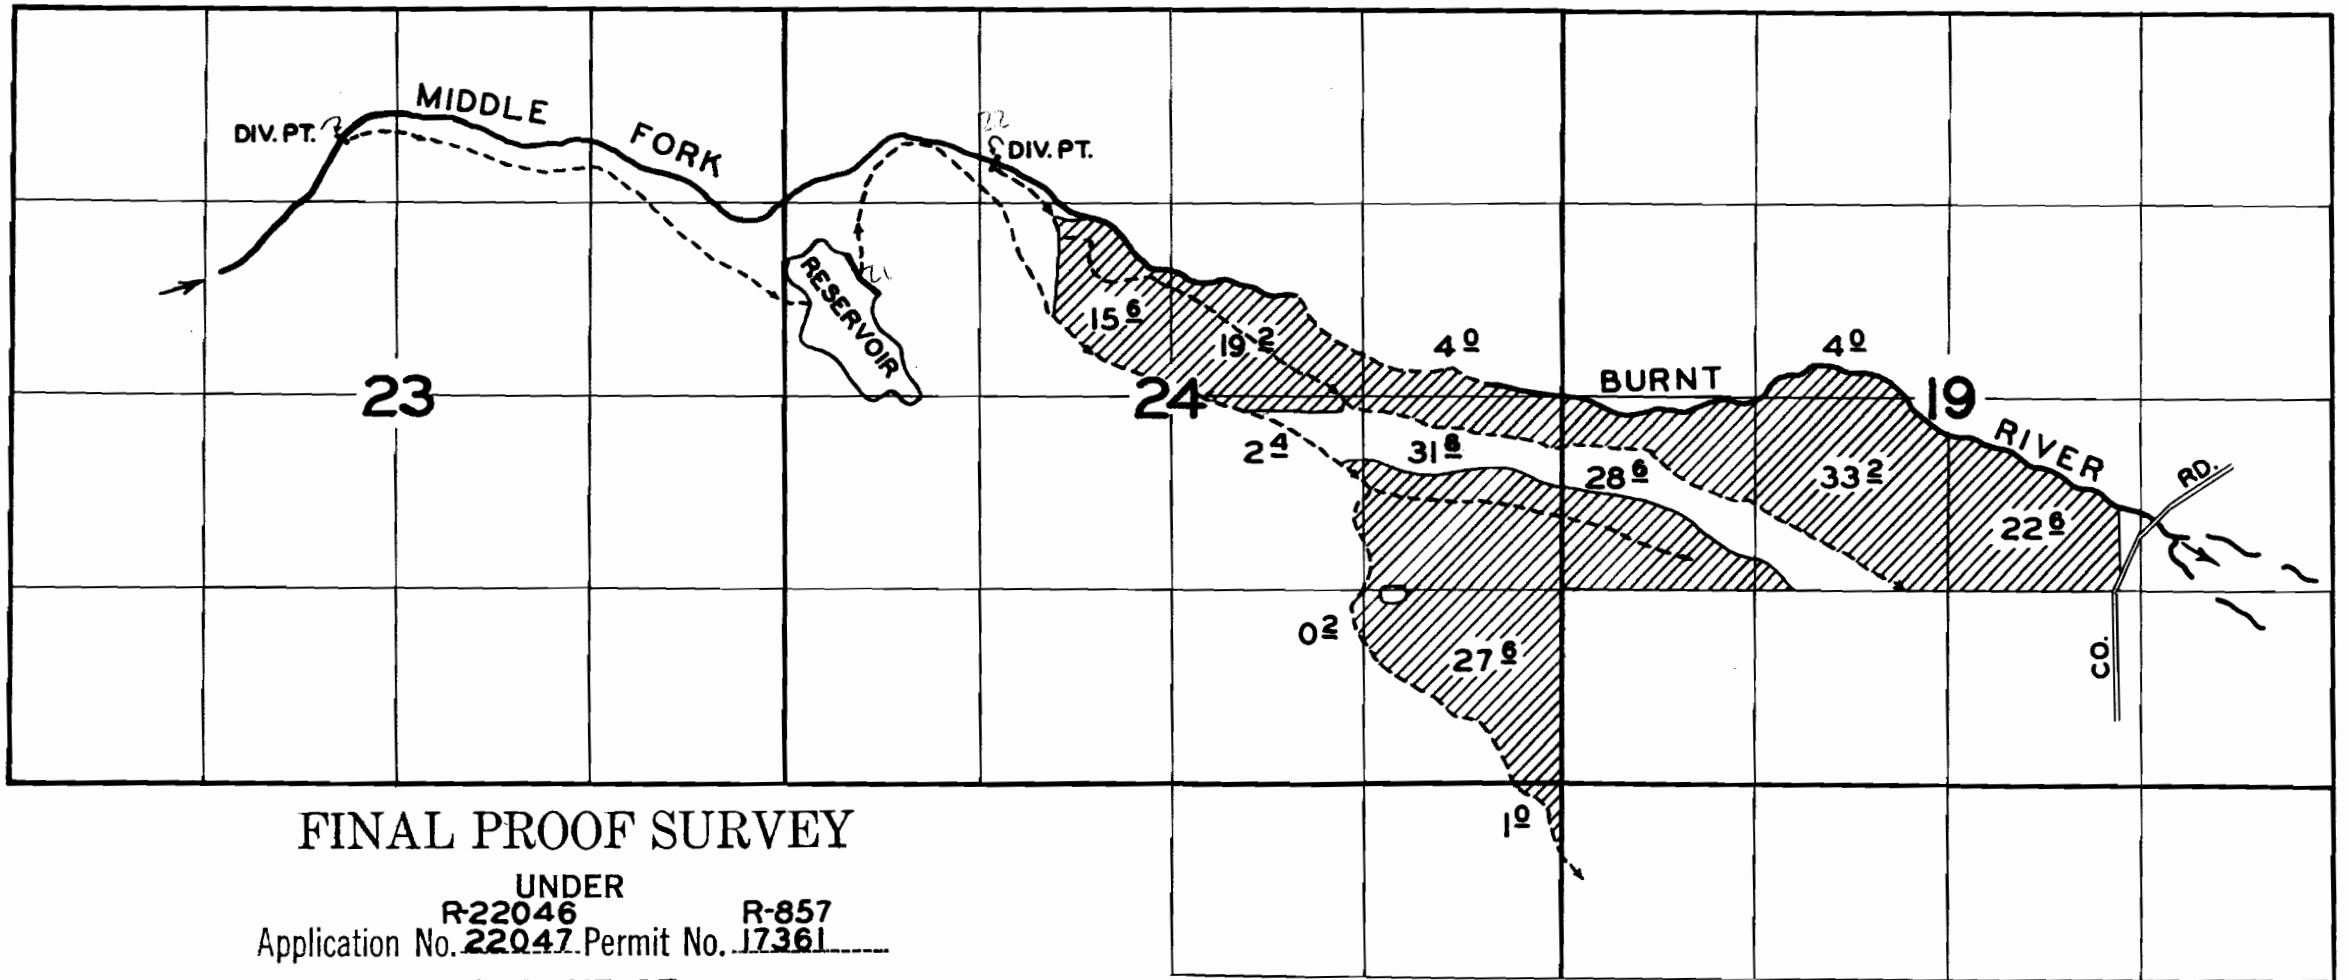

FINAL PROOF SURVEY

UNDER
Application No. R-22046 Permit No. R-857
22047 17361

IN NAME OF

Wallace Morgan

Surveyed JULY 11 1957, by A. O. Burtch