


~~18866~~

R-982

2733V

# T.40 S.R.12 E.W.M.

East River Misc. (2)

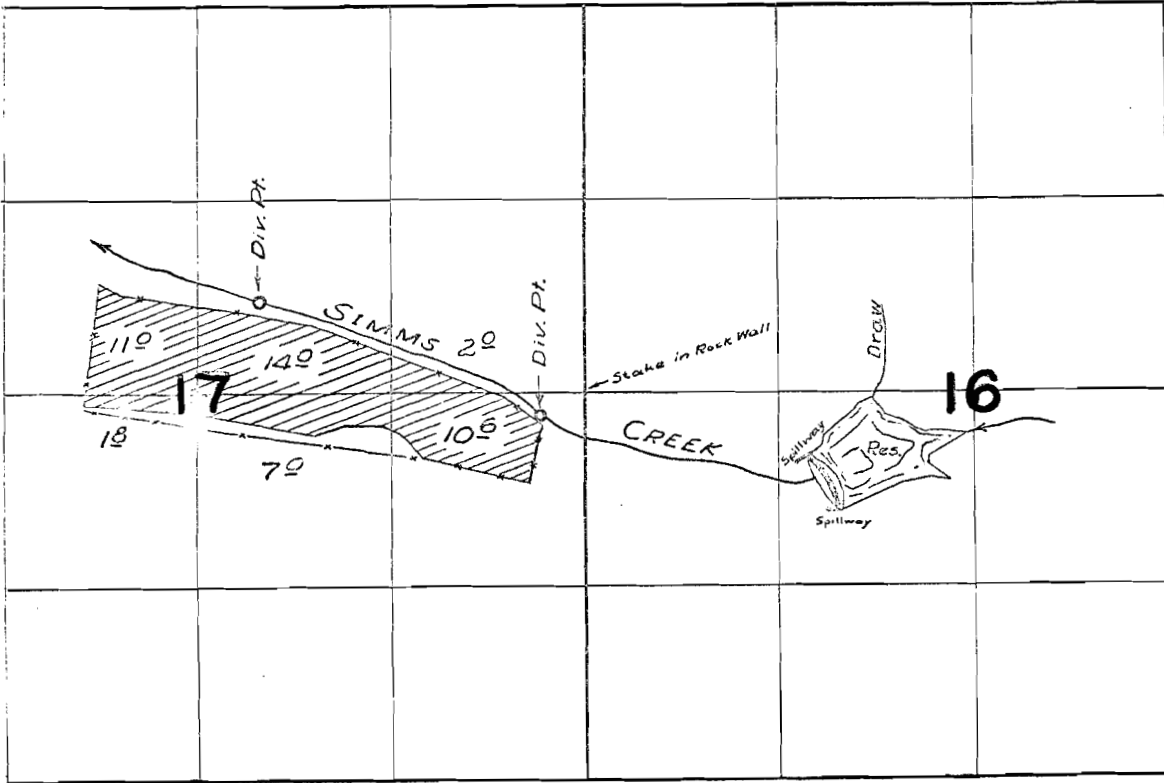

## FINAL PROOF SURVEY

UNDER

Application No. R-23511 Permit No. R-982  
23512 18866

IN NAME OF

JOHN MCFALL

Surveyed 15 Oct. 1959, by M. Rich