


T. 15. R. 39E. W.M.

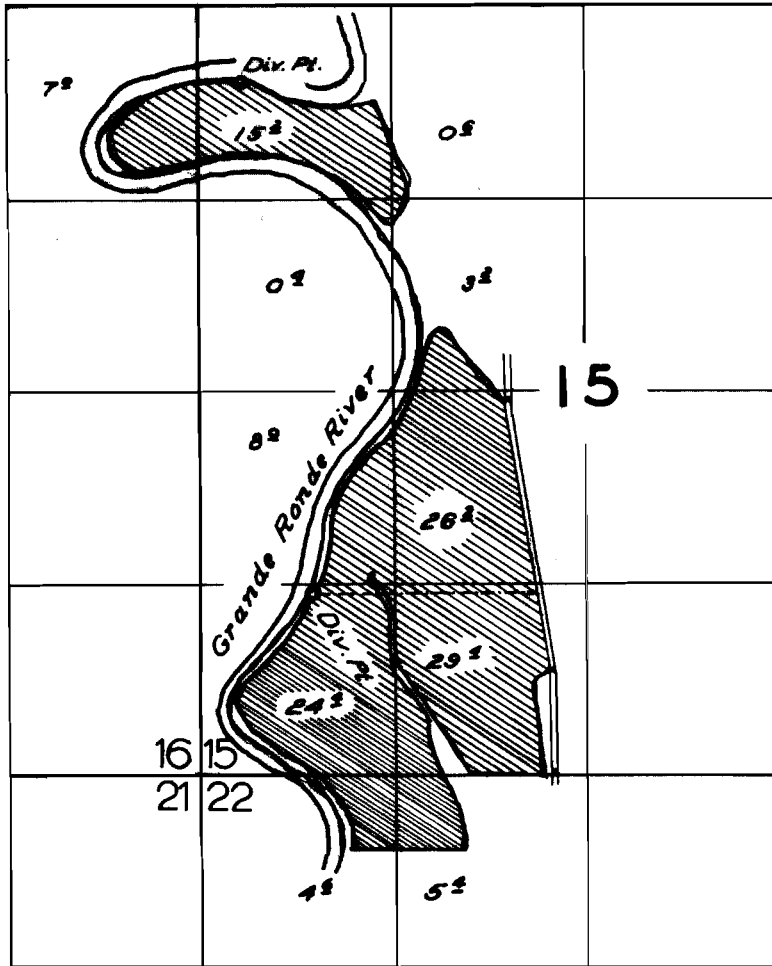

FINAL PROOF SURVEY
UNDER

Application No. 24000... Permit No. 18930...
IN NAME OF

Chase M. & Mabel S. Bohnenkamp

Surveyed Aug. 6, 1952, by R.H. Jackson.