


T.40 S.R.12 E.W.M.

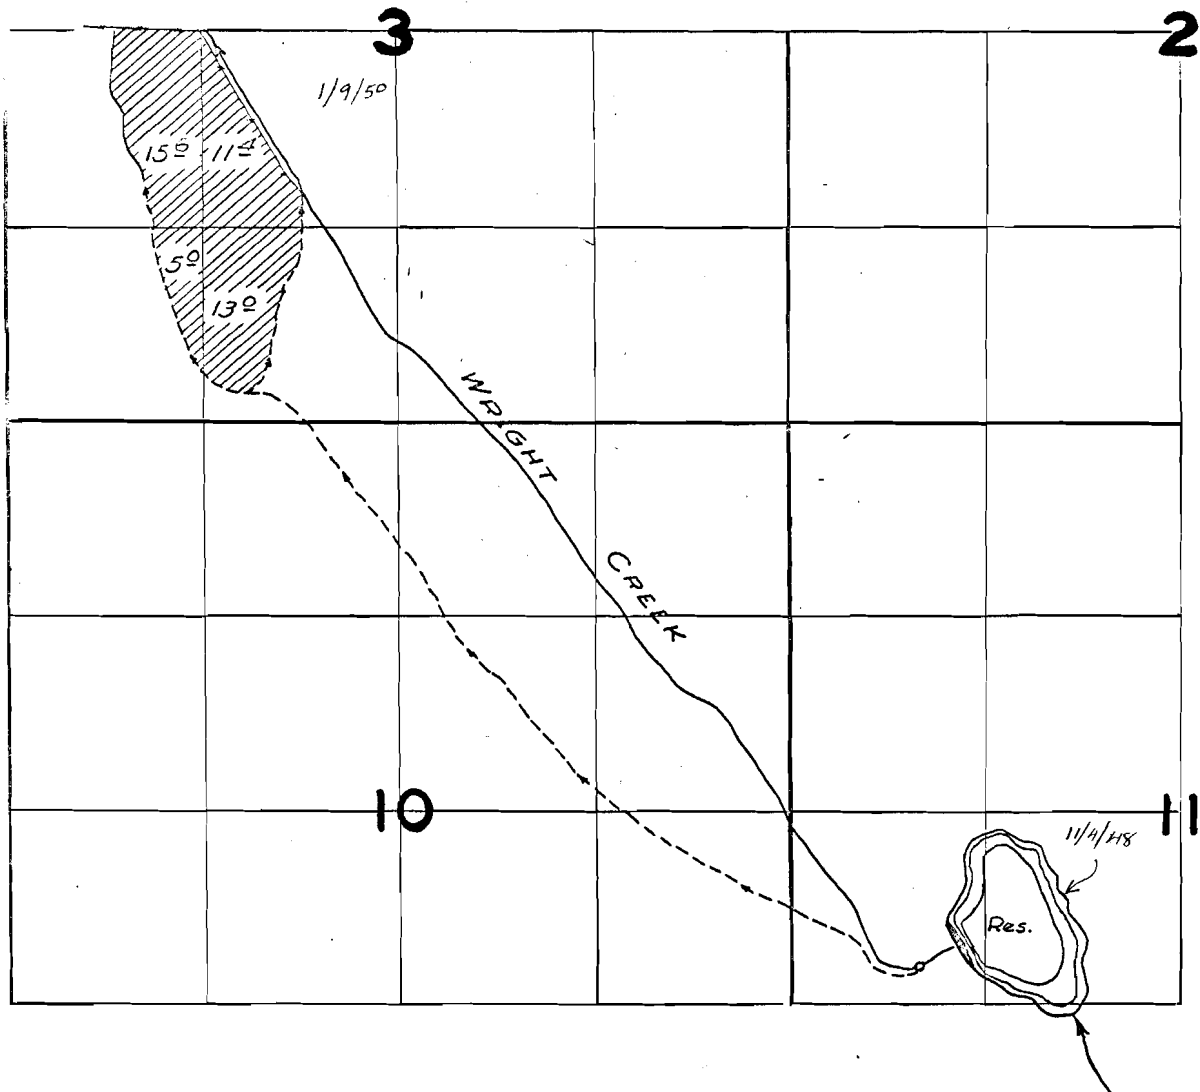

FINAL PROOF SURVEY

UNDER

R-23513

R-1003

Application No. 24392 Permit No. 19156

IN NAME OF

JOHN MCFALL

Surveyed 13 Oct. 1959, by *Tr. Bish*