


T. 2S. R. 2W.W.M.

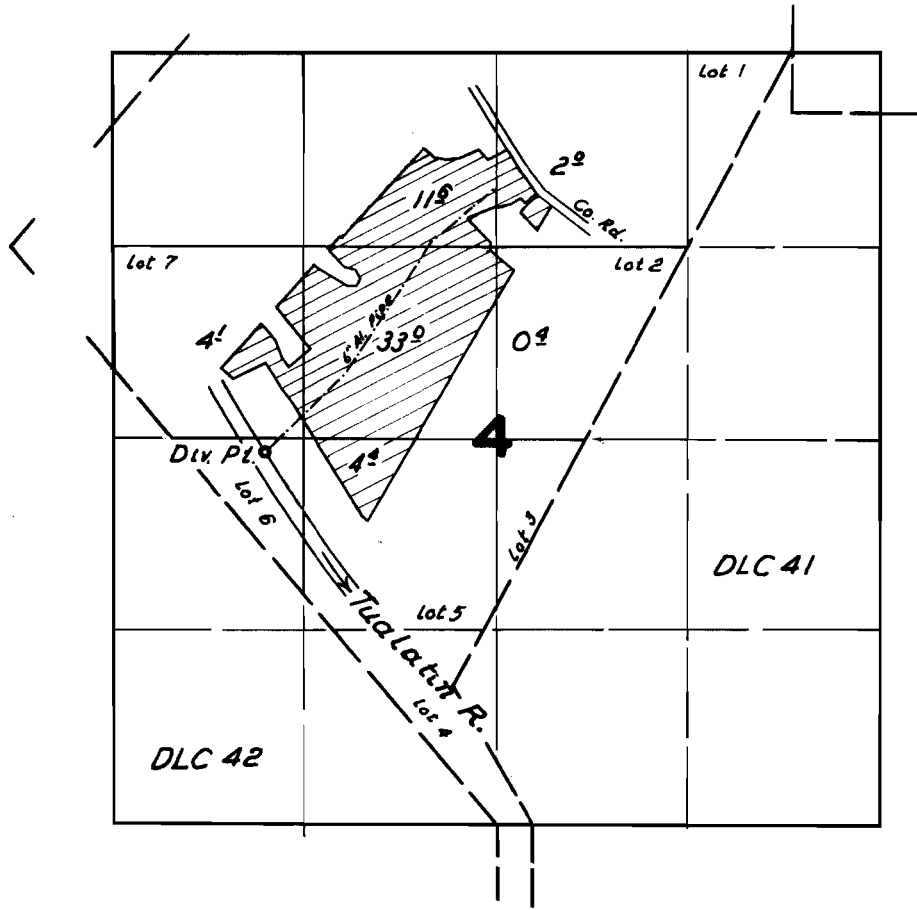

FINAL PROOF SURVEY

UNDER

Application No. 25613 Permit No. 20171.....

IN NAME OF

Ulrich Berweger

Surveyed Nov. 4 19 52., by C.O. Bantals.....