


T. 8 S. R. 10 W. W. M.

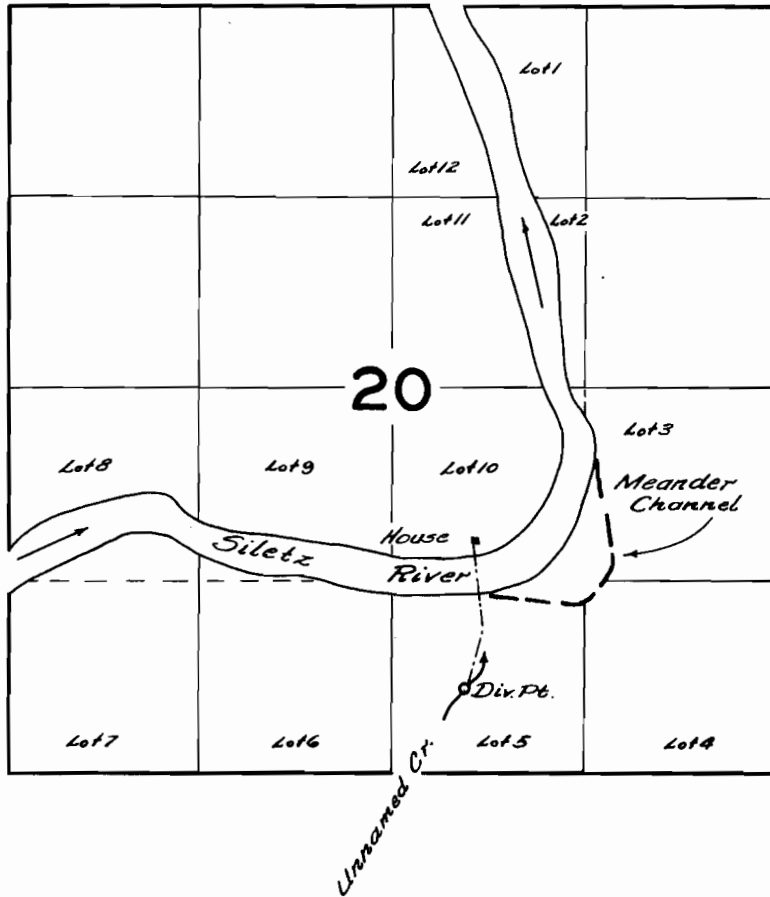

FINAL PROOF SURVEY UNDER

Application No. 26264. Permit No. 20615...
IN NAME OF

George W. Scott

Surveyed April 14 1959, by *C.O. Bault*