


T.28 S.R.44 E.W.M.

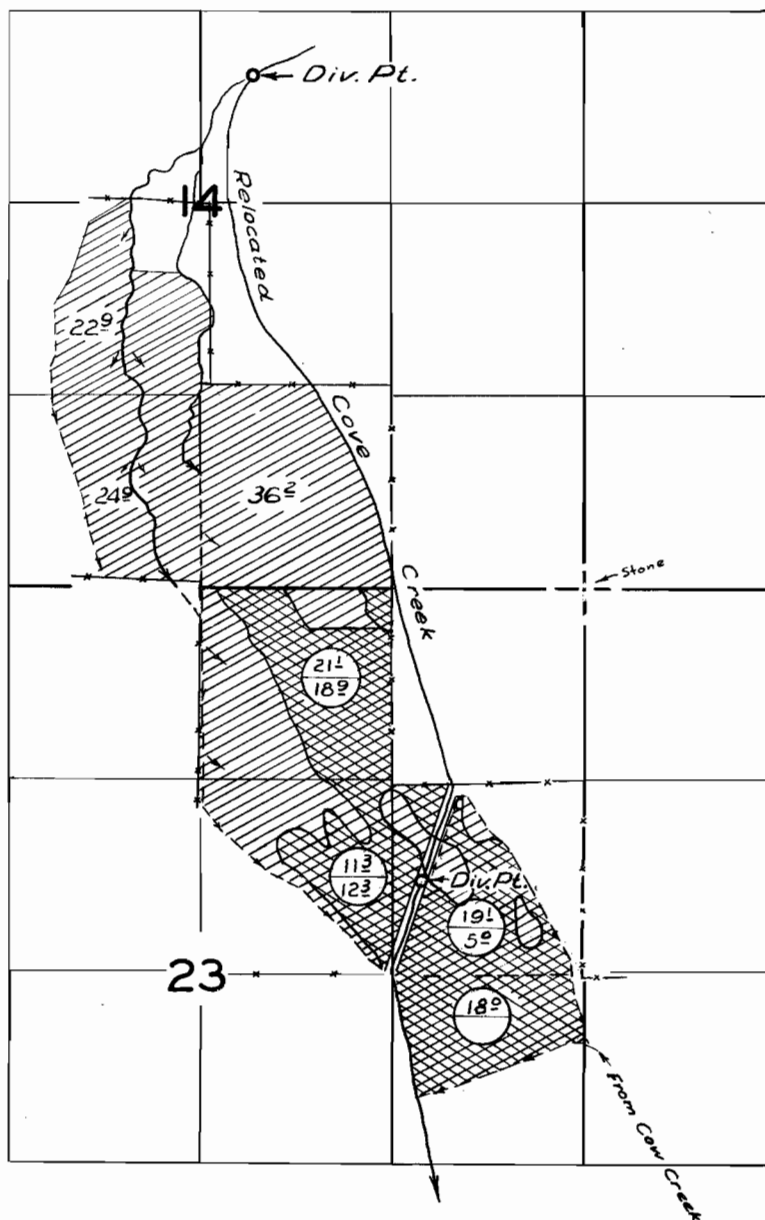

FINAL PROOF SURVEY UNDER



Application No. 25830 Permit No. 20856
IN NAME OF

N. C. LODGE

Surveyed 23 Sept. 1959, by M. Bish