



T.39&40 S.R.11&12 E.W.M.

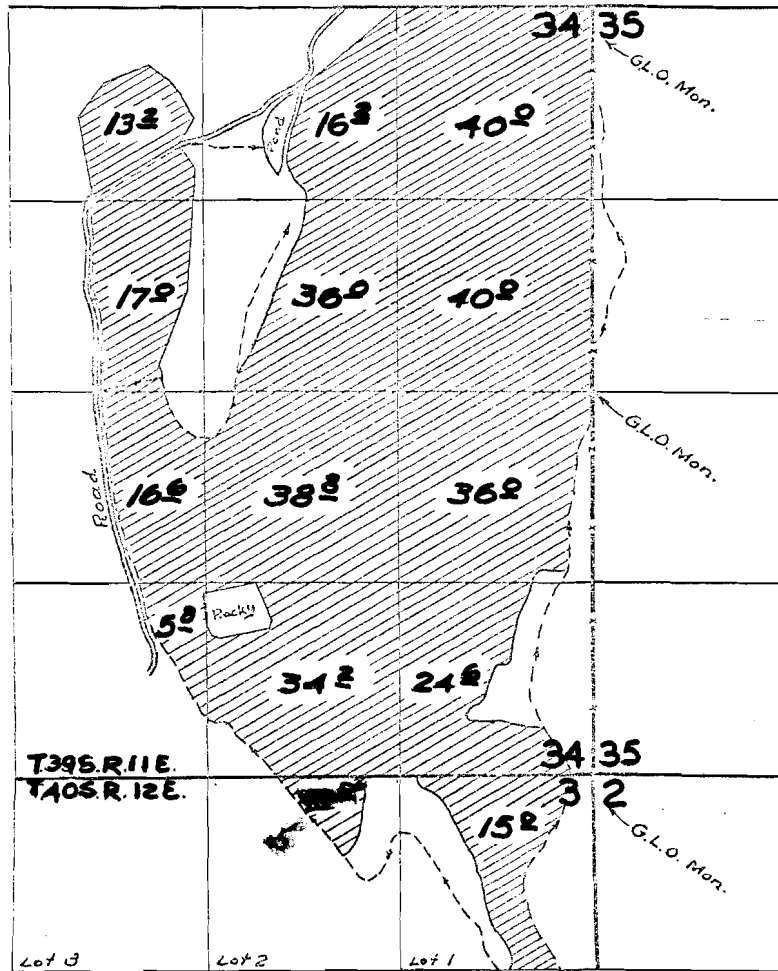

T.40S.R.12 E.W.M.

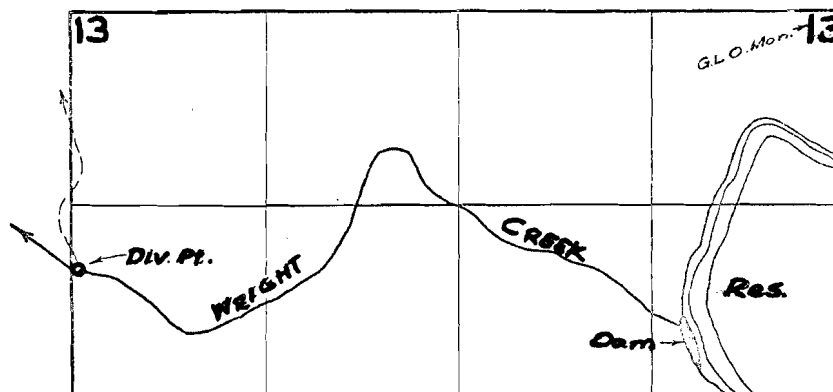

FINAL PROOF SURVEY

UNDER

R-27283

R-1368

Application No. 27284 Permit No. 2146L

IN NAME OF

JOHN MCFALL

Surveyed 13 Oct. 1959, by Tr. G. Bish

CNO-65K-72
CNO-65K-74
CNO-66K-34

East River Mac.