


T.39&40 SR.11&12 E.W.M.

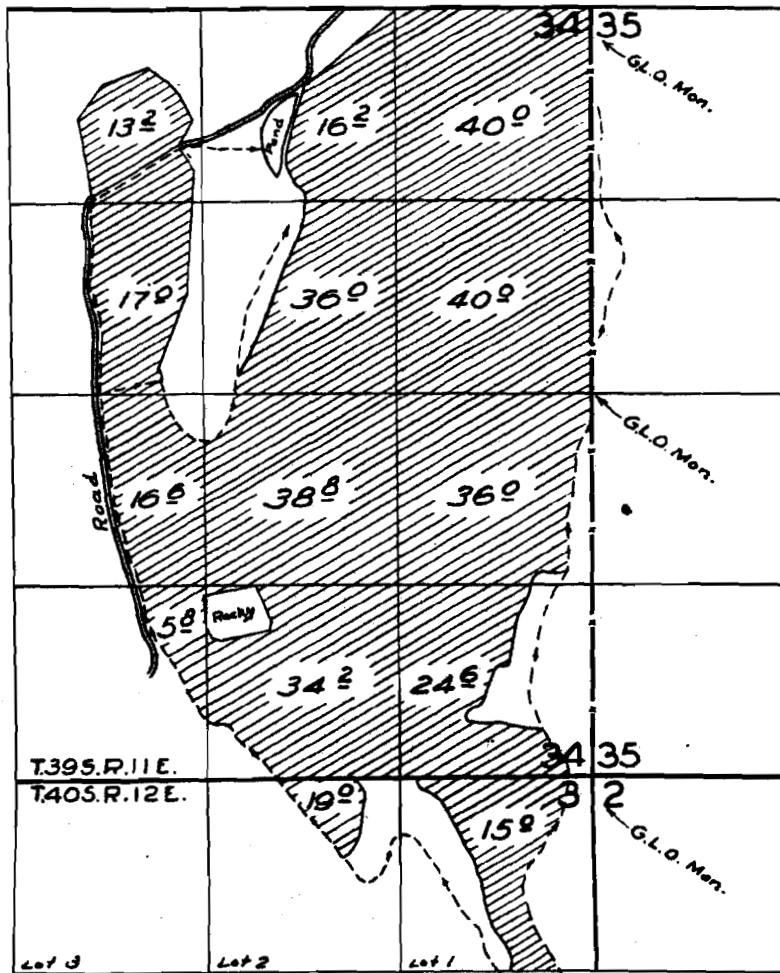


T.39S.R.11E.
T.40S.R.12E.

Lot 3

Lot 2

Lot 1

T.40 SR.12 E.W.M.

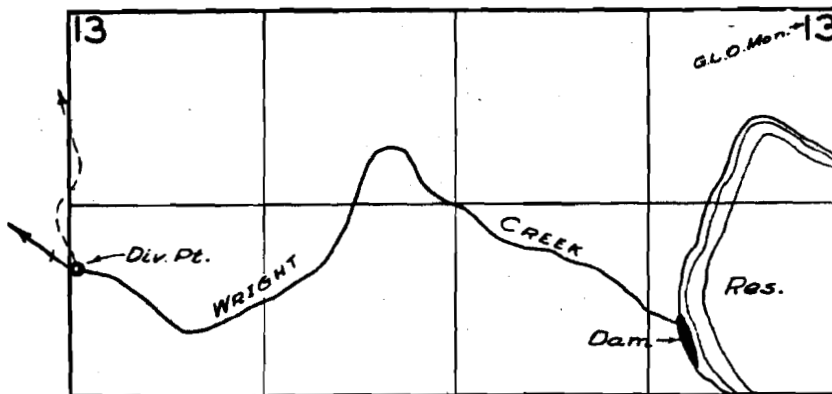

FINAL PROOF SURVEY

UNDER

R-27283

R-1368

Application No. 27284 Patent No. 21461

IN NAME OF

JOHN MCFALL

Surveyed 13 Oct. 1959 by M. G. Bush

CNO-65K-72
CNO-65K-74
CNO-66K-34

Just River miles