


Township 1 South,

Range 10 E

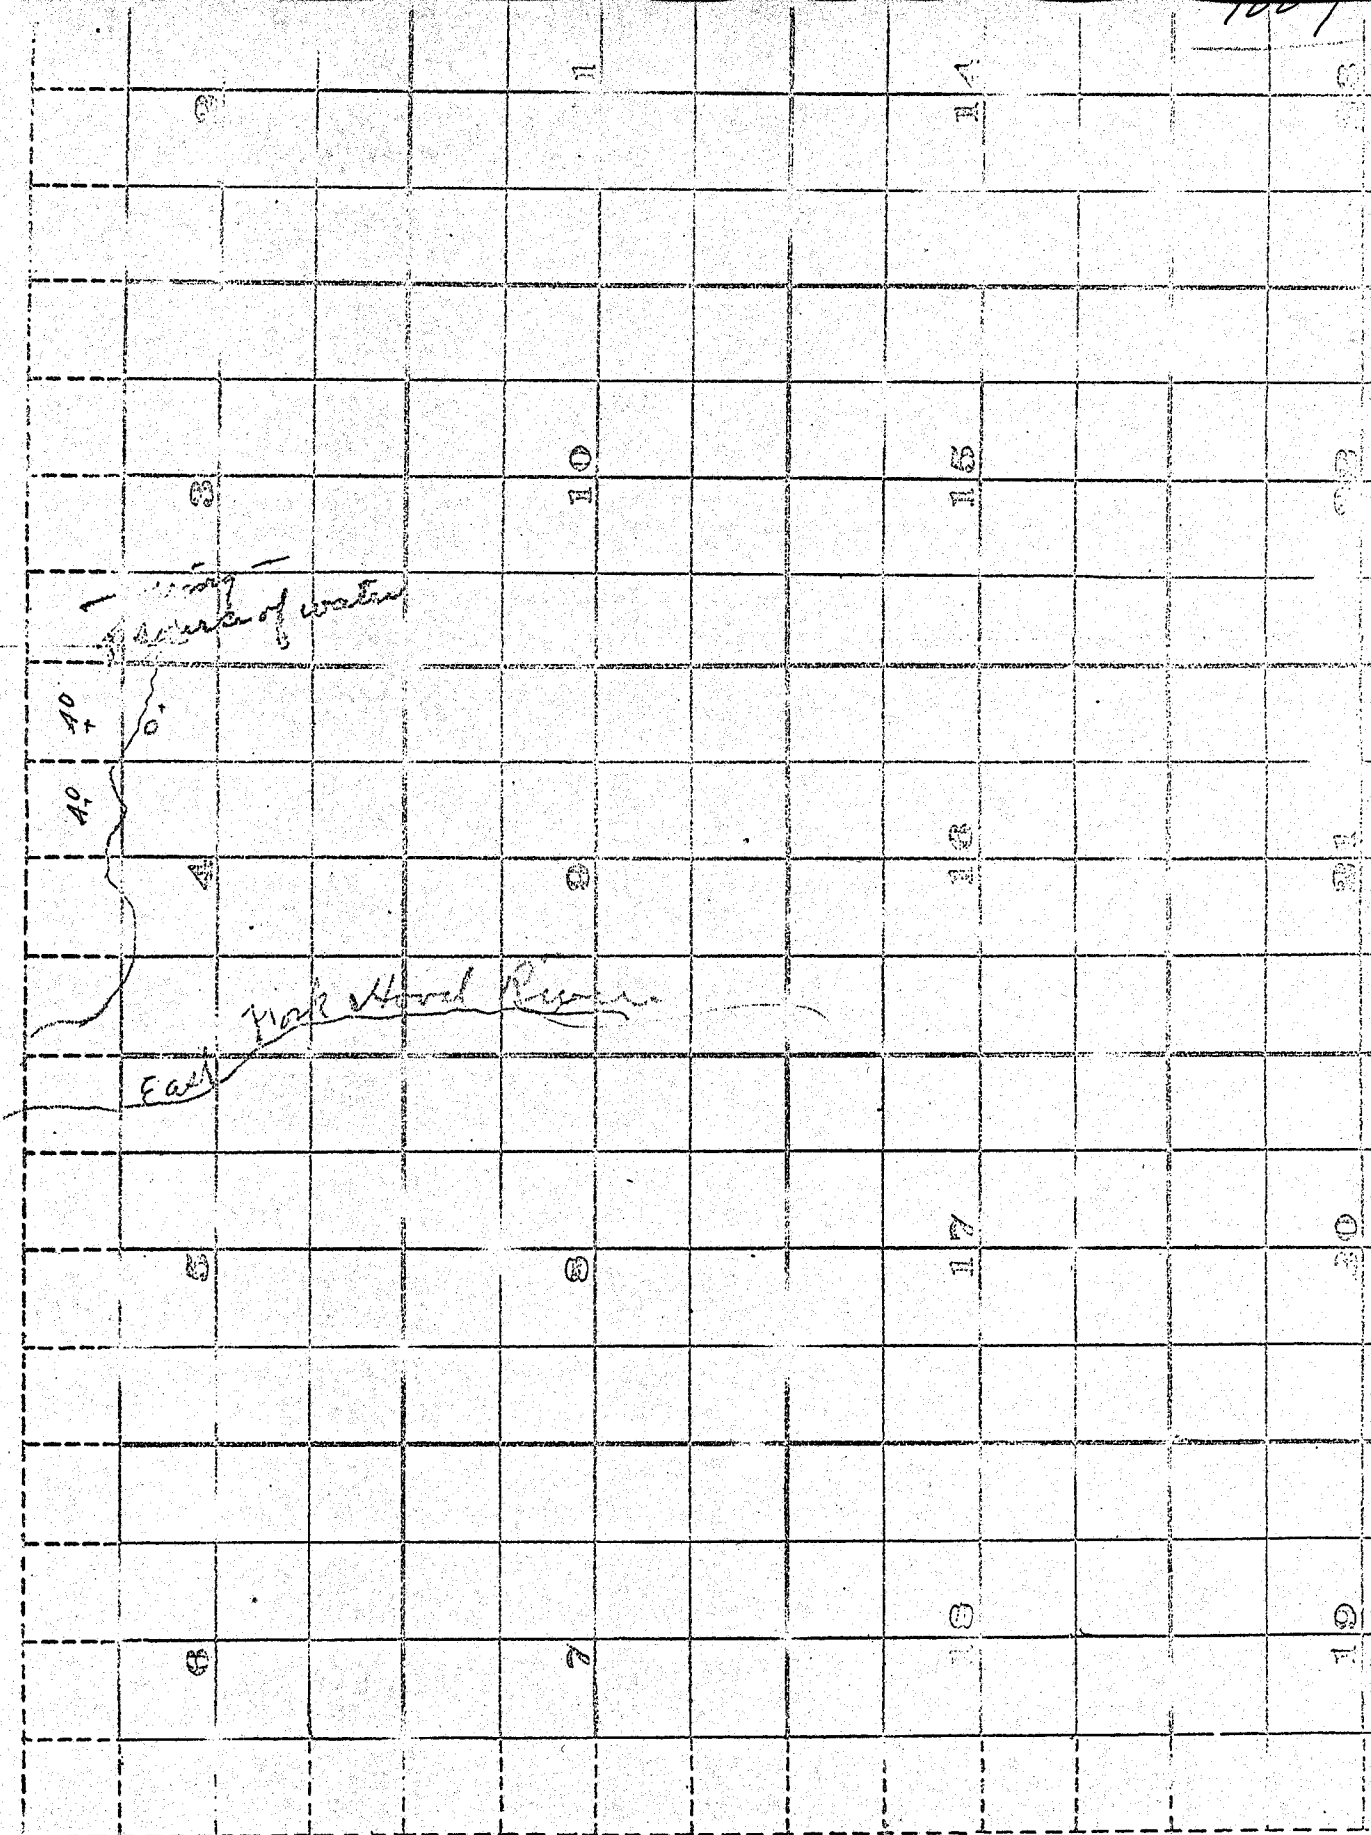

10 1930

1009