


T.40 S.R.8 W.W.M.

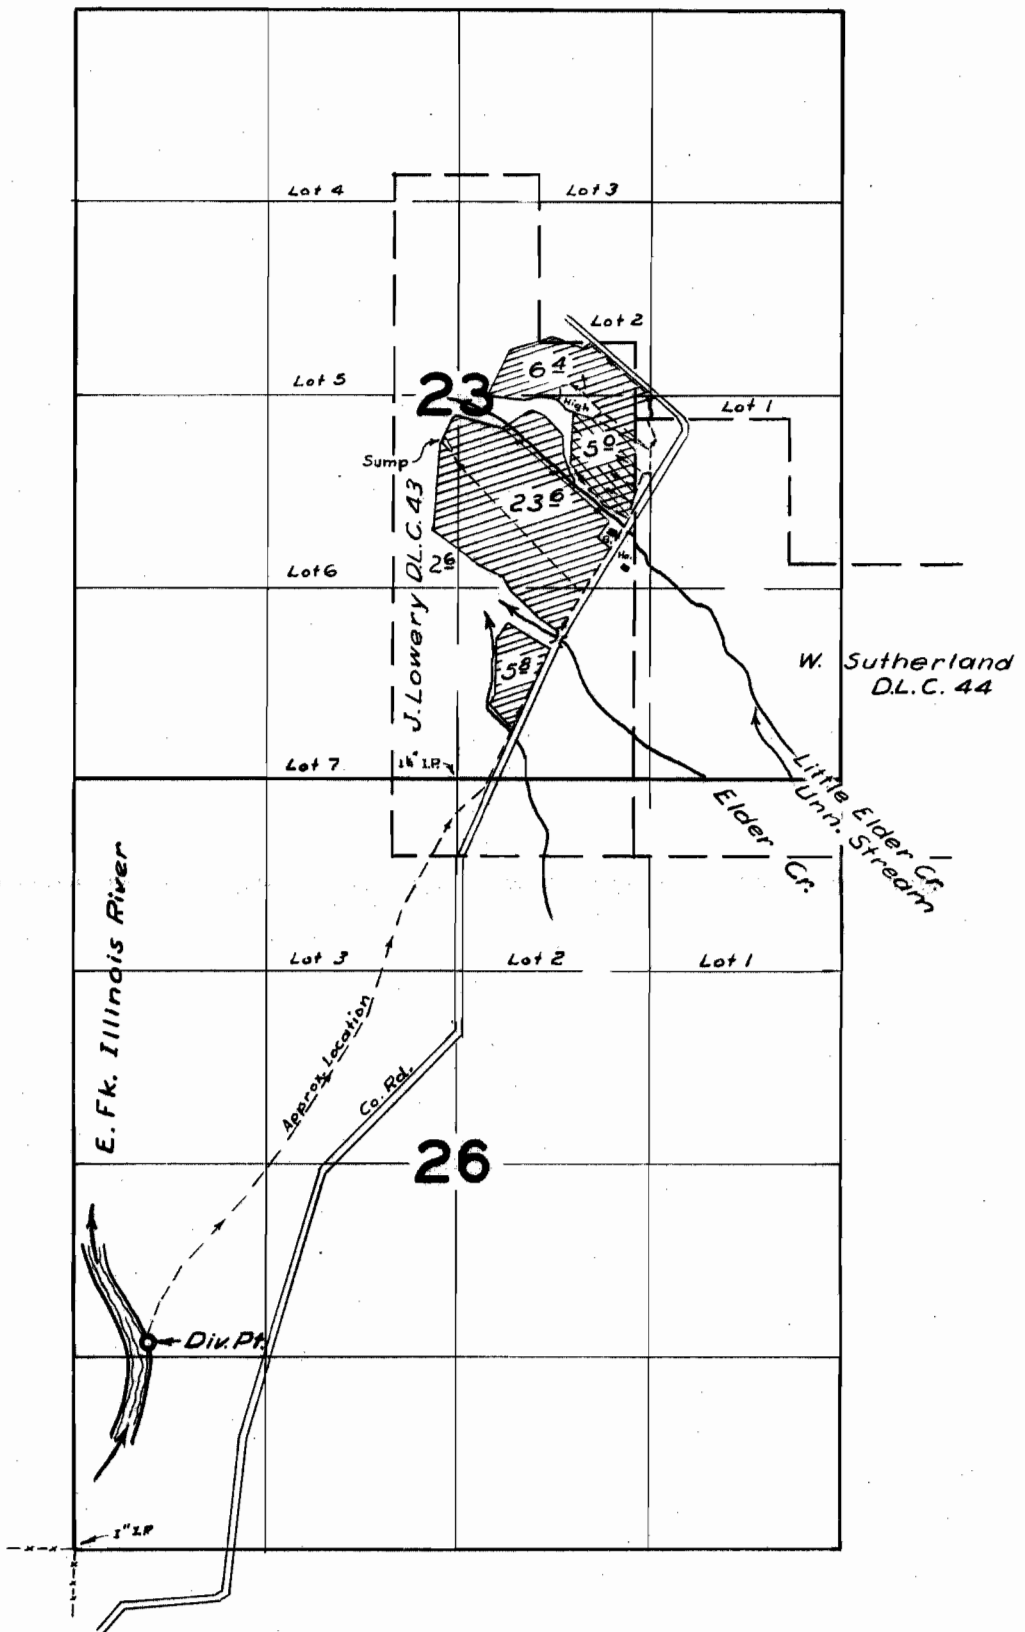

FINAL PROOF SURVEY

UNDER

Application No. 27571 Permit No. 21713

IN NAME OF

ARNOLD W. BUCKENDAHL

Surveyed 14 July 1959, by M. G. Sch