


T. 4 S. R. 5 W. W.M.

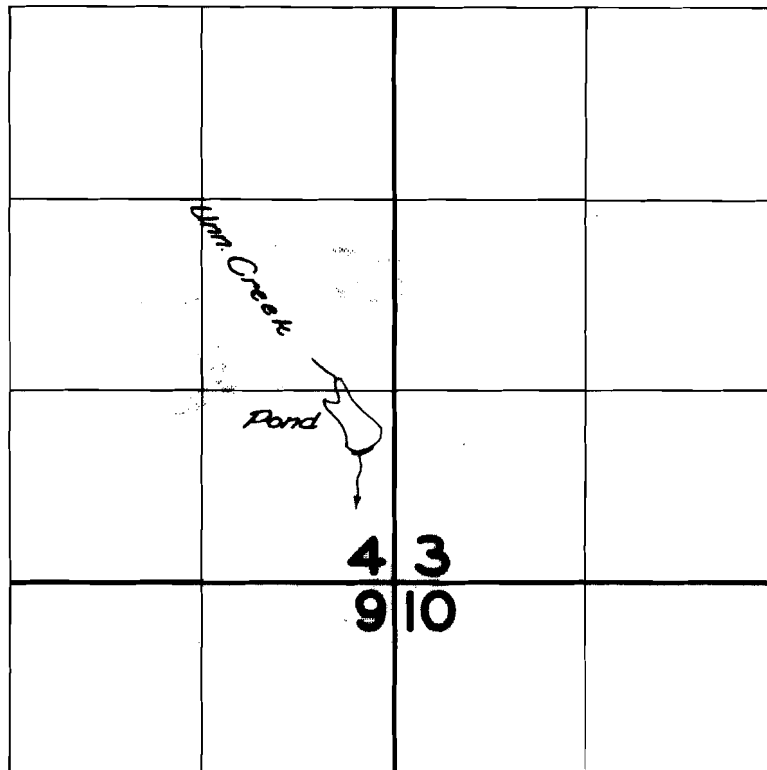

FINAL PROOF SURVEY
UNDER

Application No. ^{R-27604} ~~27605~~ Permit No. ^{R-1428} ~~21746~~
IN NAME OF

Bernard A. & Gertrude S. Callison

Surveyed May 5 1958, by M. Bish