


T.14 S.R.6 W.W.M.

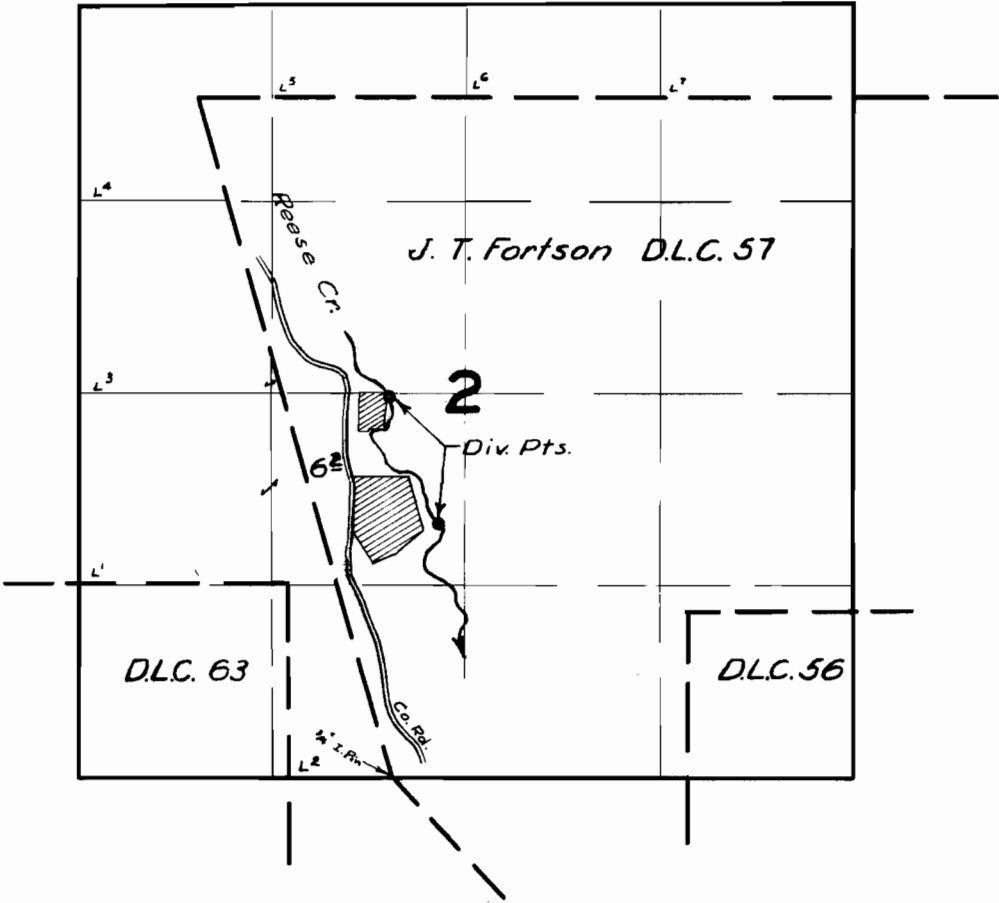

FINAL PROOF SURVEY
UNDER

Application No. 27678 Permit No. 21793
IN NAME OF

.....*CHARLES PUTNEY*.....

Surveyed 9 Mar. 1959, by *M. Bish*