


T.16 S. R.6 W.M.

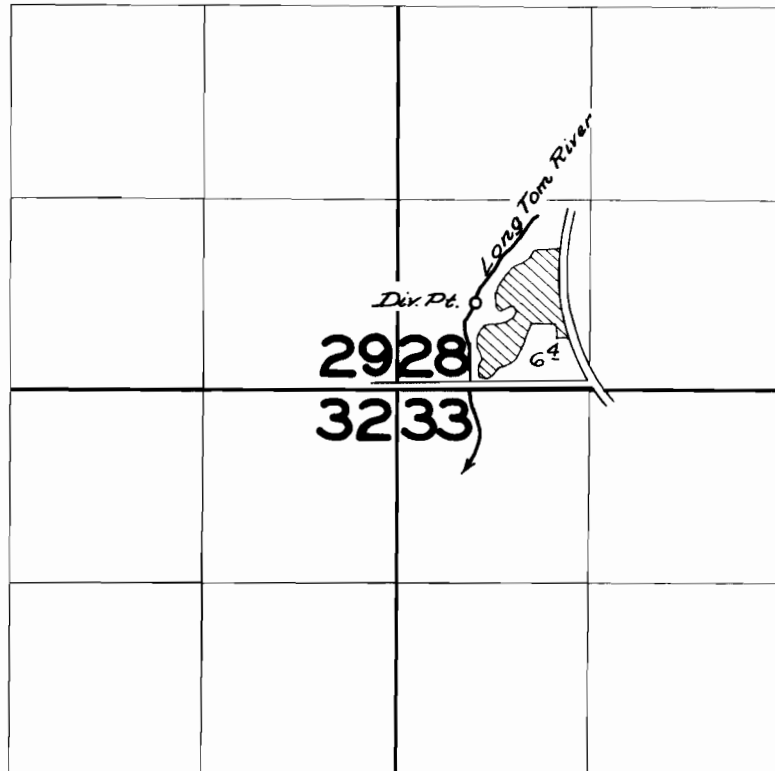

FINAL PROOF SURVEY
UNDER

Application No. 28069... Permit No. 22079...
IN NAME OF

..... Edward B. Brasier

Surveyed April 1, 1959, by C.D. Baitle