


T. 1S. R. 4E. W.M.

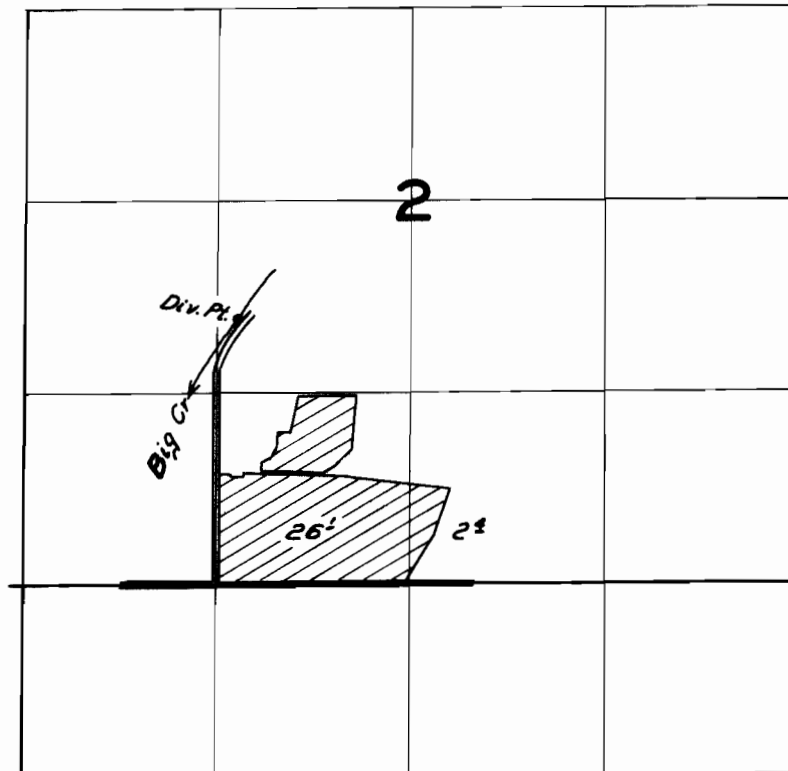

FINAL PROOF SURVEY
UNDER

Application No. 28612 Permit No. 22539
IN NAME OF

Walter Vockert

Surveyed June 2 1959, by C. O. Bartels