


Application No. 46901
Permit No.

SW $\frac{1}{4}$ NW $\frac{1}{4}$ Sec 36 T55 R11W

Application No. 341322
Permit No. 26898

Place
Residence

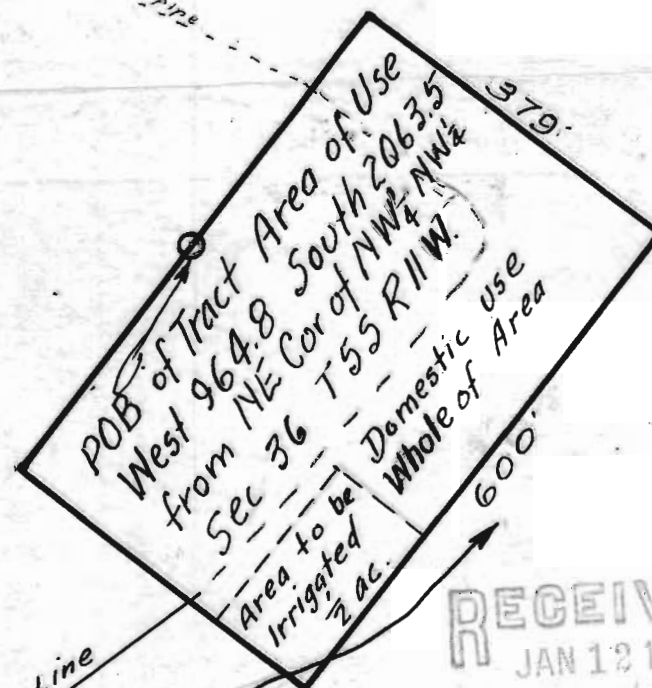

WATER RIGHT
O. A. PLACE
Secs. 35-36 T55
R11W. W.M.

Point of Diversion
South 2987.3'
West 1604.0'
from NE Corner
of NW $\frac{1}{4}$ NW $\frac{1}{4}$ Sec 36 T55 R11W. W.M.

I, W.A. Markham, of Arch Cape Oregon.
certify that this map was made from
notes of an actual survey made by
me in 1951. wamarkham



RECEIVED
JAN 12 1954
STATE ENGINEER
SALEM, OREGON

RECEIVED
NOV 27 1953
STATE ENGINEER
SALEM, OREGON

Application No. 28781
Permit No. 22656