


T.40 S.R.7 W.W.M.

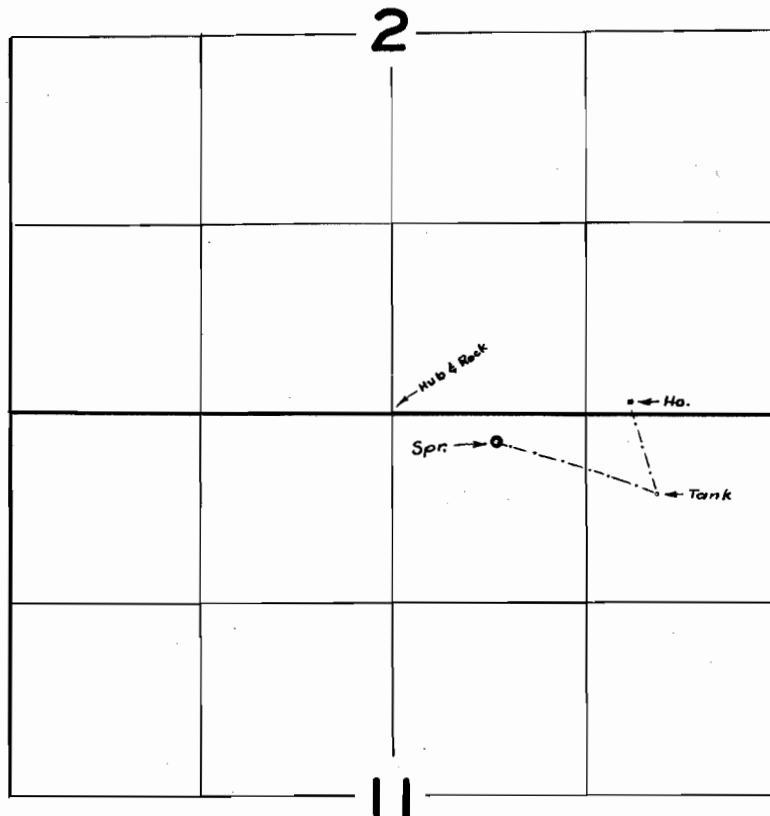

FINAL PROOF SURVEY
UNDER

Application No. 29427 Permit No. 23171
IN NAME OF

RAYMOND DENTON

Surveyed 15 July 1959, by M. Bish