


T. 1S. R. 4E. W.M.

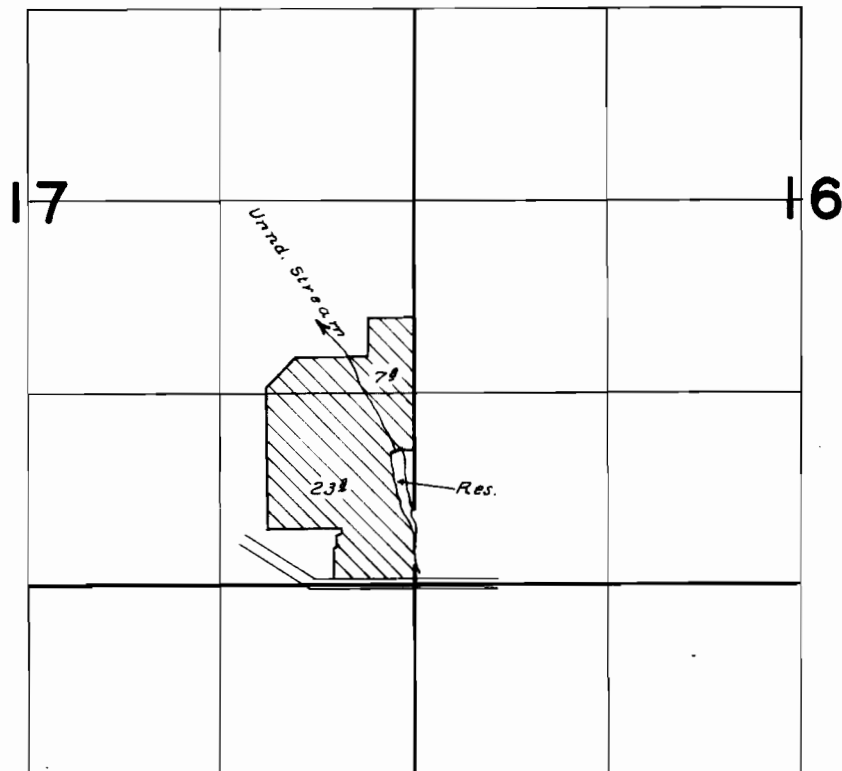

FINAL PROOF SURVEY
UNDER

R28616 *R1702*
Application No. *28617* Permit No. *23327*
IN NAME OF

Daryl M. Lundborn

Surveyed *June 2 1959*, by *C.O. Bartels*