


T. 3 S. R. 3 E. W.M.

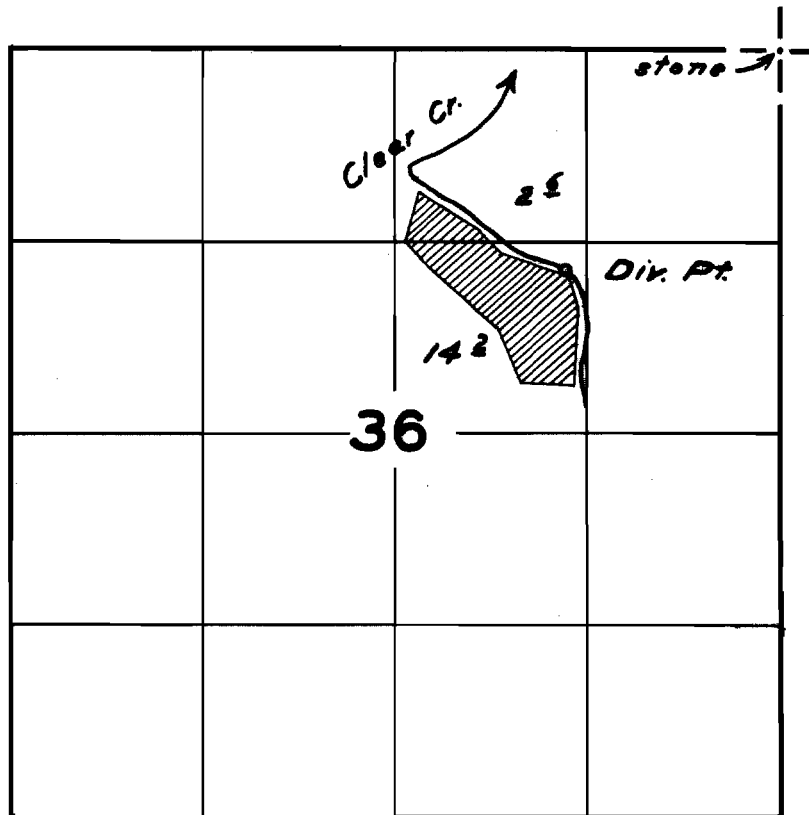

FINAL PROOF SURVEY
UNDER

Application No. 29868 Permit No. 23473
IN NAME OF

George Wicker

Surveyed Sept. 2 1958, by W. N. Perry